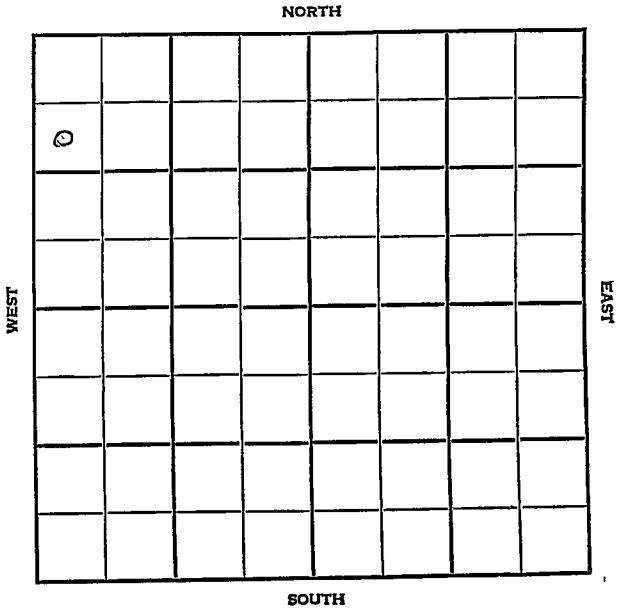


Section 5 Township 35 Range 13WWell No. 1 Walsh-SternbergerCompany Continental Oil & City Prod.

Barber

KANSAS

SEC.

TWP.

R.

5

35

13 W

WELL NO.

1 Walsh-Sternberger

FARM

COMPANY

Continental Oil & City Products

CONTRACTOR

Coppinger

Wildcat

990 Ft. from N. Line

Ft. from S. Line

Ft. from E. Line

330 Ft. from W. Line

SW NW NW

NORTH							
WEST	0						
SOUTH							
EAST							

Sohio & CSO - DHM

ELEVATION

REPORT

1955

3/30

MIR

County Barber State KansasSec. 5 (Blk. Twp.) 35 (Sur. Rge.) 13W Map No.Operator Continental Oil & City ProductsWell No. 1 Farm Walsh-SternbergerElev. Location SW NW NW

0					

990 Ft. From N Line NW330 Ft. From W Line Quarter1st. Report MAR 30 1955

Completion

Remarks Sohio & CSO - DHMCoppinger - Contr.

Spudding Date

Drilg. Data WildcatM I R

FABEN GILSTRAP