


Section 5 Township 35 Range 12WWell No. 1 Bank UnitCompany Barbara Oil (Amerada 25%)

NORTH

WEST

EAST

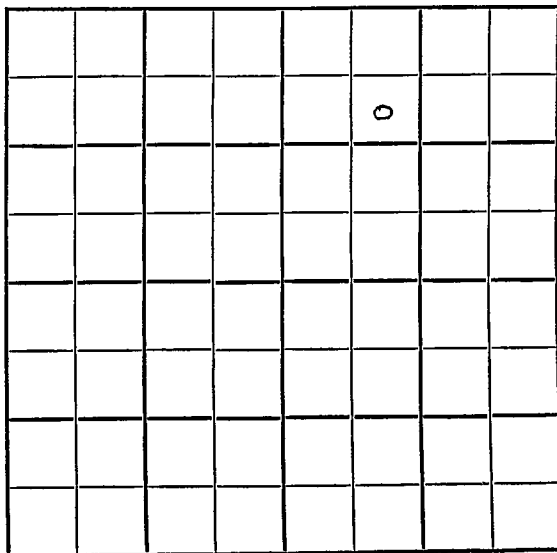

SOUTH

Barber

KANSAS

SEC.	TWP.	R.
5	35	12 W

WELL NO.

1 Bank Unit

FARM

COMPANY

Barbara Oil (Amerada 25%)

CONTRACTOR

Hardtner Pool

990

Ft. from N. Line


Ft. from S. Line

Ft. from E. Line

990

Ft. from W. Line

SE NW NE

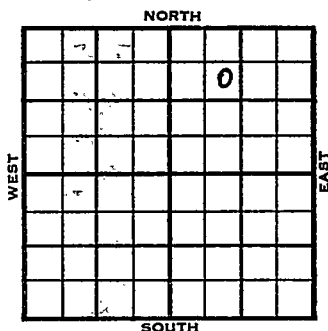

1955

ELEVATION

1477

REPORT

3/30

Spud 3-29-55

6/8

Comm 3-29-55

Tp B Oread 2 3920

H Stal 4172

CE Sd 4792

M 4805

TD 4940

8" @ 226, DST 3634-3700 open 1 hr

Rec 335' sw 1345/20", DST 4765-4805
open 1 hr Rec 20' ocm 69/20"DST 4798-4841 open 2 hr Rec 190' gcm
150/20" DST 4844-4910 open 2 hrRec 225' gsocm 150/20" DST 4910-40
open 2hr Rec 100' mud 140/20"

5 1/2" @ 4940 CO 80/4913-26 frac

F/10 to 11 boph P/92.24 bo 13 hr 17%
wtr 14% SW P/27.54 bo 40% wtr

12 hr S/1 1/2 bfph 58% wtr 2 hr

PB 4850 48/4790-98 1 mcfgpd

Temp abd

ABANDONED

FABEN GILSTRAP

Scout Cards	mm
Land Small Map	
Land Wall Map	33
Tracings	
France Map	
Pierce Map	
Misc.	

MAR 31 1955

Orig. Data

County	Barber ✓	Elev.	1477
Sec.	5	Twp.	35
		Rge.	12W
Company	Barbara Oil		
Farm Name	Bank Unit	No.	1

TOPS	DEPTH	LOG	DATUM	Loc. in Sec.
Anh.				
Tp. B. Oread	3920		2443	SE NW NE
H. Stal	4172		2695	
Tr.				
Dg.				
BL.				
L.				
K.C.				Geol.
B.K.C.				
Ce. sd	4792		3315	Contr.
C.				
M.	4805		3328	
M.				Pool
K.				Hartner
Mz.				
Me.				
V.				
S.				
S.				
A				
R.				
Pe.				
G.				
Tp.	4940			

Date Comm. 3-29-55 JUN 8 1955

8" @ 226 DST 3634-3700 open 1 hr.
 Rec. 335' sw 1345/20" DST 4765-4805
 open 1 hr. Rec. 20' ocm 69/20"
 DST 4798-4841 open 2 hr. Rec. 190' gcm
 150/20" DST 4844-4910 open 2 hr.
 Rec. 225' gsocm 150/20" DST 4910-40
 open 2 hr. Rec. 100' mud 140/20"
 5½" @ 4940 CO 80/ 4913-26 frac

OVER

JUN 27 1955

Scout Cards	<u>h m c</u>
Land Small Map	_____
Land Wall Map	_____
Tracings	_____
France Map	_____
Pierce Map	_____
Misc.	_____

E/ 10 to 11 boph P/ 92.24 bo 13 hr.
17% wtr. 14% sw P/ 27.54 bo 40% wtr.
12hr. S/ 1 $\frac{1}{2}$ bfrp 58% wtr. 2 hr.
PB 4850 . 48/ 4790-98 1 mcf gpd
Temp. bdd.