


Section 5 Township 35 Range 12 WWell No. # 1 ~~Ill. National Bank of Springfield~~ *Bank Unit*Company Barbara Oil

NORTH

WEST

EAST

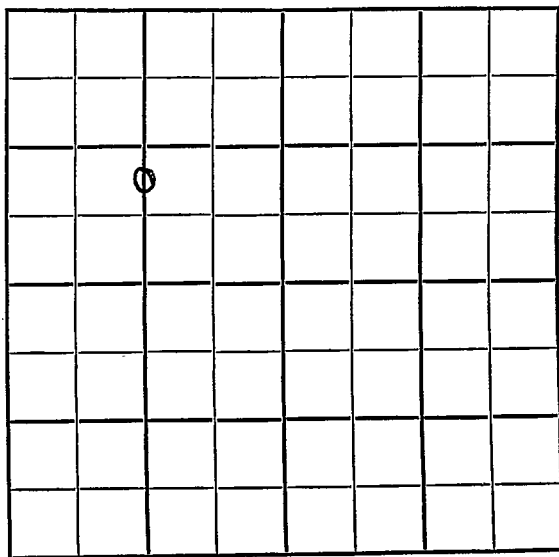

SOUTH

Barber

KANSAS

SEC.	TWP.	R.
5	35	12W

WELL NO.

~~BANK UNIT~~#1 ~~Ill. National Bank of Springfield~~

COMPANY

Barbara Oil

CONTRACTOR

Patton Drlg.

Hardtner Pool

1621


Ft. from N. Line

Ft. from S. Line

Ft. from E. Line

1320

Ft. from W. Line

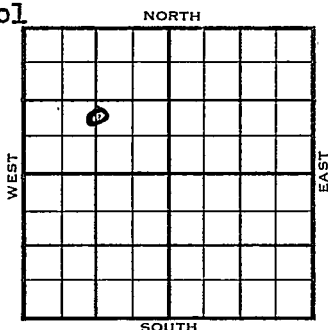C N $\frac{1}{2}$ S $\frac{1}{2}$ NW

	ELEVATION	REPORT
1955	1477	

1/26

C & P

6/22

Elgin 3692

Burg 4775

L Sd 4796

Lans 4366

M 4806

TD 4871

8" @ 257/175 DST 3726-84 open 1 hr

Rec 3250' sw 1410# DST 4755-4809

gas in 2 min open 1 $\frac{1}{2}$ hr 6,000 mcfg

1870/20" DST 4809-40 open 2 hr

gas in 8 min. Rec 1115' oil

1415/20" DST 4840-71 open 2 hr

Rec 125' ocm 773/20" 5" @ 4871

CO 48/4791-99 3 mcfg SI 24 hr

4,600 mcfg 1650# SI 45 hr. open

15 min 4,690 mcfg frac 4 mcfg

Comp open flow 18 mcfgpd

COMPLETED

County **Barber** State **Kansas**

Sec. **5** (Blk.) **35** (Sur.) **12W** Map No.

Operator **Barbara Oil**

Well No. **1** Farm **Ill. National Bank of**

Elev. Location **C N $\frac{1}{2}$ S $\frac{1}{2}$ NW Springfield**

FIRST REPORT

1621Ft. From **N** Line **NW**

1320Ft. From **W** Line **Quarter**

1st. Report **JAN 2 6 1955**

Completion

Remarks

Patton Drlg. - Contr.

Spudding Date

Drlg. Data

Hardtner Pool

Cellar & pits

FABEN GILSTRAP

JAN 31 1955

Travel Cards	
Land Survey Map	
Land Wall Map	
Tramway	
France Map	
Other Map	

Dirg. Data

SCOUT TICKET

DX-201

Kansas

SEC.

5

TWP.

35

R.

12W

WELL NO.

1 Bank Unit

FARM

COMPANY

Barbara Oil

CONTRACTOR

CORRECTION


C N $\frac{1}{2}$ S $\frac{1}{2}$, NW

1621 FT. FROM N. LINE

FT. FROM S. LINE

FT. FROM E. LINE

1320 FT. FROM W. LINE

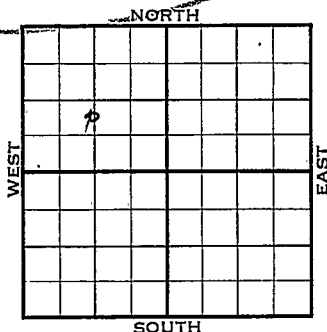

Barber County

☐

LOCATION

☐

RIG UP

DRILLING AND REMARKS:

Reported
Ill. Nat'l Bank
of Springfield

RECORD

CASED IN., FT.

SAND

GAS

OIL

TOTAL DEPTH

1ST 24 HRS. NAT.

1ST 24 HRS. AFTER SHOT

GAS CU. FT.

DRY HOLE

ABANDONED

PRODUCTION

DATE

MAR 9 1955

SCOUT

FABEN GILSTRAP

Page

W

to 1000

1, 1000

12 1000

1000

1000

1000

1000

1000

Scout Cards	mm
Land Small Map	
Land Wall Map	5
Tracings	
France Map	
World Map	
etc.	

MAR 14 1955

1000

1000

County Barber Elev. 1477
 Sec. 5 Twp. 35 Rge. 12W
 Company Barbara Oil
 Farm Name Bank Unit No. 1

TOPS	DEPTH	LOG	DATUM	Loc. in Sec.
Anh.				C N $\frac{1}{2}$ S $\frac{1}{2}$ NW
Tp.				
H. <u>Elgin</u>	<u>3692</u>		<u>2215</u>	1621' NL
Tr.				
Dg.				1320' WL
BL. <u>Burg</u>	<u>4775</u>		<u>3298</u>	
L. <u>sd</u>	<u>4796</u>		<u>3319</u>	
K.C. <u>Lans</u>	<u>4366</u>		<u>2889</u>	Geol.
B.K.C.				Contr.
Ce.				Patton
C.				
M.	<u>4806</u>		<u>3329</u>	Pool
M.				Hardtner
K.				
Mz.				
Mo.				
V.				
S.				
S.				
A.				
R.				
Pe.				
G.				
T.D.	<u>4871</u>			

COMPLETE

Date Comm. JUN 22 1955
8" @ 257/175 DST 3726-84 open 1 hr.
Rec. 3250' sw 1410# DST 4755-4809
gas in 2 min. open 1 $\frac{1}{2}$ hr. 6,600 mcf/g
1870/20" DST 4809-40 open 2 hr.
gas in 8 min. Rec. 1115' oil 1415/20"
DST 4840-71 open 2 hr. Rec. 125' ocm
773/20" 5" @ 4871 CO 48/ 4791-99
3 mcf/g *SI 24 hr. 4,600 mcf/g 1650#

JUN 30 1955

Scout Cards	<u>mm^c</u>
Land Small Map	<u> </u>
Land Wall Map	<u> </u>
Tracings	<u> </u>
France Map	<u> </u>
Pierce Map	<u> </u>
Misc.	<u> </u>

SI 45 hr. open 15 min. 4,690, mfg
frac 4 mfg
Comp. open flow 18 mfgpd