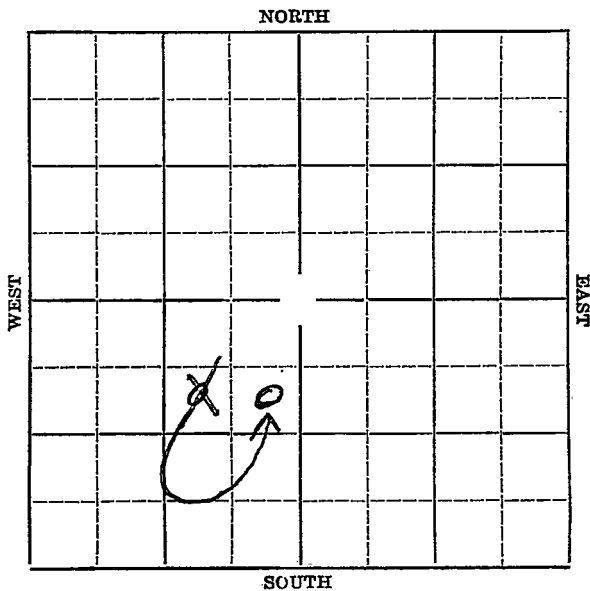


Section 6 Township 35 Range 39-WWell Number 1-6 GreeningCompany Texas Inter-State

Well No. #1-6 Greening Farm


Texas Inter-State Company

990' Ft. from N. Line

Ft. from S. Line

~~990~~ Ft. from E. Line

Ft. from W. Line

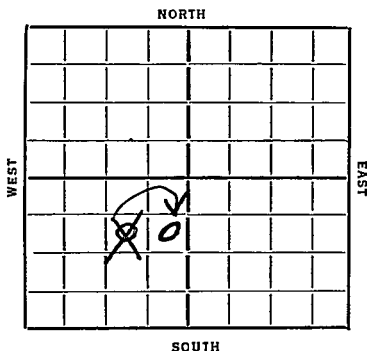

Date
1936

REPORT

6/17	Location
------	----------

6/25--7/2--7/9--

7/16 10" @ 537'.

7/23--

7/30 Drlg. 2653'.

8/6--

8/13 Drlg. 2798!.

8/20--

8/26/36-Gas sand 2662'.

T.D. 2880'.

Water 2870-80'.

P.B. 2820¹.

1-7/10 million cuft of gas.

~~COMPLETED~~

KANSAS

Map No. No Map Sec. 6 Twp. 35 R. 39WWell No. 1-6 GreeningTexas Inter. State Company

Contractor

SECTION PLAT

	0		

990 Ft. from N. Line

_____ Ft. from S. Line

990 Ft. from E. Line

_____ Ft. from W. Line

FIRST REPORT

Location ✓

Rig up _____

Drilling and Remarks: _____

RECORD

Cased _____ in., _____ ft.

Sand _____

Gas _____

Oil _____

Total Depth _____

PRODUCTION

1st 24 hrs. Nat. _____

1st 24 hrs. after shot _____

Gas _____ Cu. Ft.

Dry Hole _____

Abandoned _____

Date

JUN 17 1936

19


S. J. LEWIS

Scout

Map No. No 122 Sec. 6 Twp. 35 R. 39WWell No. 1 - 6 GreningTexas Inter State Company

Contractor

SECTION PLAT

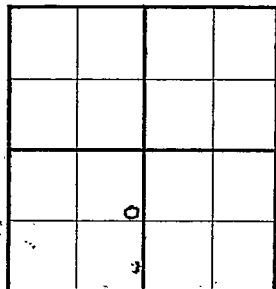990 Ft. from N. Line

_____ Ft. from S. Line

330 Ft. from E. Line

_____ Ft. from W. Line

CORRECTION

Location _____

Rig up _____

Drilling and Remarks:

ReportedOK. NE OK.

RECORD

Cased _____ in., _____ ft.

Sand _____

Gas _____

Oil _____

Total Depth _____

PRODUCTION

1st 24 hrs. Nat. _____

1st 24 hrs. after shot _____

Gas _____ Cu. Ft.

Dry Hole _____

Abandoned _____

Date

6/17/36 19 Scout


Map No. 114 Sec. 6 Twp. 35 R. 39W

Well No. 1-6. Greening


Contractor

SECTION PLAT

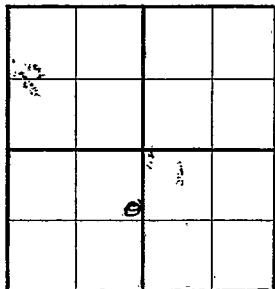

990 Ft. from N. Line

_____ Ft. from S. Line

230 Ft. from E. Line

_____ Ft. from W. Line

COMPLETED

Location _____

Rig up _____

Drilling and Remarks:

Gas Sand.

2662

Water 2870-80

P.B. 2820

1 7/10 M Gas

RECORD

Cased _____ in., _____ ft.

Sand _____

Gas _____

Oil _____

Total Depth 2880

PRODUCTION

1st 24 hrs. Nat. _____

1st 24 hrs. after shot _____

Gas _____ Cu. Ft.

Dry Hole _____

Abandoned _____

Date

AUG 26 1936

19

S. J. LEWIS Scout