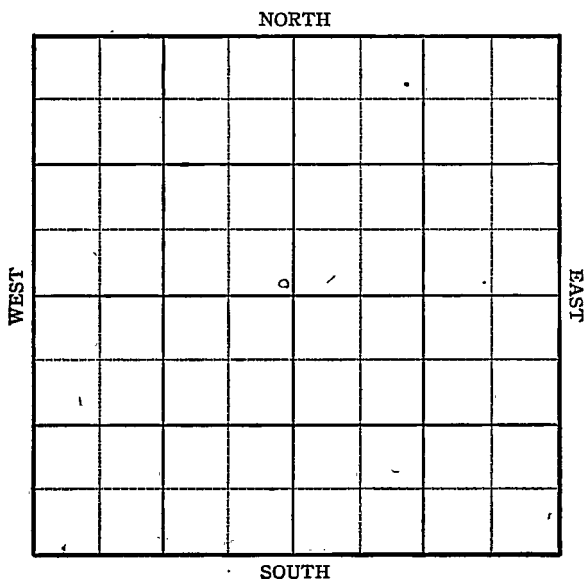


KANSAS

Stevens

FORM 51 5M PETROL

Section 6 Township 35 Range 35WWell No. 1 HaworthCompany Texas & Skelly

KANSAS Stevens

Sec. 6 Twp. 35 R. 35-W

Well No. #1 Haworth Farm


Texas & Skelly Company

 Ft. from N. Line

100 Ft. from S. Line

100 Ft. from E. Line

 Ft. from W. Line

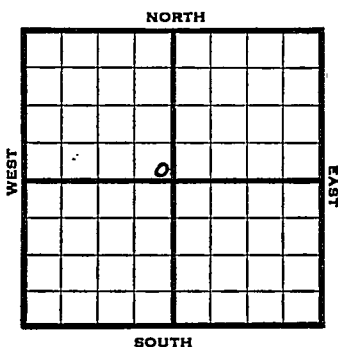

SE NW

1945

Elev. 3011

REPORT

10/3 Drlg. 70'
10/10 Lost Hole at 667
TD 667
Skid rig 50'
Drlg. 716'
10/17 1828 fsg.
10/24 2700 TD
10/31 7" @ 2699
Drlg. 2721
11/7 TD 2822 3 M Gas
11/14 13,500 acid.
16,900,000 Gas.
12000 acid. Testing
11/21 7" @ 2699
128' of 5" Liner
396' shots 2722-2822
25,500 acid.
TD 2822
21,996,000 Gas.
420# R Pr.

COMPLETED

KANSAS

Kansas

Pool Name HugotonMap No. is in map Sec. 6 Twp. 35 R. 35WWell No. 1 HaworthTexas & Skelly

Company

IRST REPORT

Contractor

SE NW

SECTION PLAT

		0	

 Ft. from N. Line100 Ft. from S. Line100 Ft. from E. Line Ft. from W. Line

Stevens County

Location Rig up

Drilling and Remarks:

700

RECORD

Cased in., ft.Sand Gas Oil Total Depth

PRODUCTION

1st 24 hrs. Nat. 1st 24 hrs. after shot Gas Cu. Ft.Dry Hole Abandoned

Date

OCT 3 1945 19

S. J. LEWIS

Scout

KANSAS

Kansas

Pool Name HugotonMap No. 10M¹P Sec. 6 Twp. 35 R. 35WWell No. 1 Haworth

Texas & Skelly

Company

COMPLETED

Contractor

SE NW

E 1, 2011
SECTION PLAT

Ft. from N. Line


100

Ft. from S. Line

100

Ft. from E. Line

Ft. from W. Line

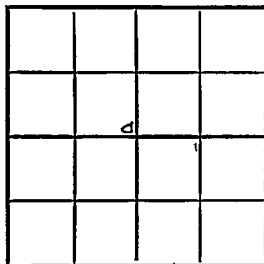

Stevens County

Location

Rig up

Drilling and Remarks:

7" @ 2689125' of 5" Linel896 slt to 2722-282225500 acid21,996,000 Gas420 R/P

RECORD

Cased _____ in., _____ ft.

Sand _____

Gas _____

Oil _____

Total Depth 2822

PRODUCTION

1st 24 hrs. Nat. _____

1st 24 hrs. after shot _____

Gas _____ Cu. Ft.

Dry Hole _____

Abandoned _____

Date

NOV 21 1945

19

S. J. LEWIS

Scout