


Section 6 Township 35 Range 34-W

Well No. #2 Dowdy

Company Plains Natural Gas

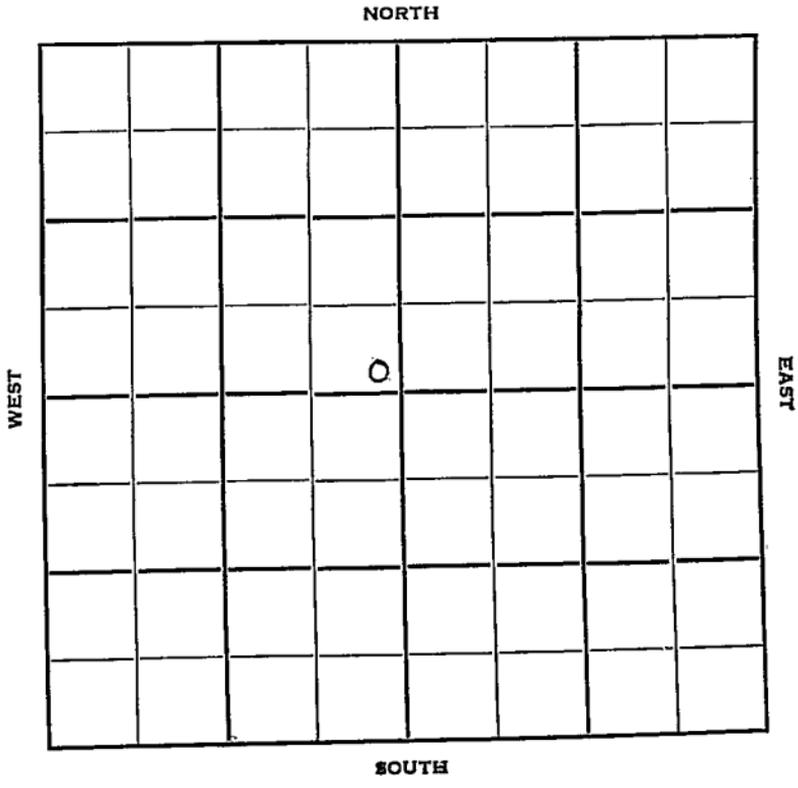

Sec. 6 Twp. 35 R. 34-W

Well No. #2 Dowdy Farm

Plains Natural Gas Company

Mid-Western Contractor

Hugoton


Ft. from N. Line

300 Ft. from S. Line

200 Ft. from E. Line

Ft. from W. Line

SE NW

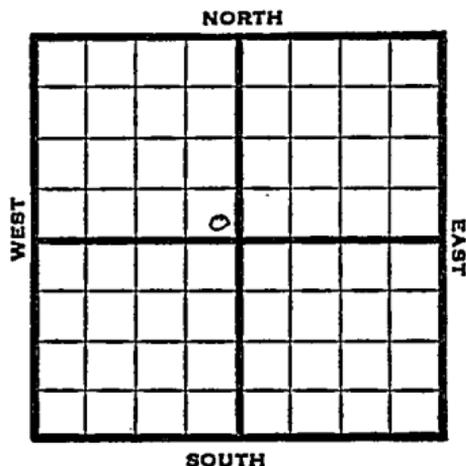

1950

Elv. 2944

REPORT

8/2

Location

92/0

Spud 8-6-50
 Gas Well TD 2955'
 10 $\frac{1}{2}$ " @ 541' 7" @ 2749'
 Hol. 2583' Her 2646'
 Krider 2672'
 25/2745-50 60/2680-90
 48/2654-62 30/2647-52
 Total Acid 23,000
 Comp. 1,625,000 gas 423#

COMPLETED

Kansas

Map No. _____ Sec. 6 Twp. 35 R. 34W

Well No. 2 Dowdy

Plains Natural Gas Company

Mid-Western Contractor

SE NW

SECTION PLAT

_____ Ft. from N. Line

200 Ft. from S. Line

200 Ft. from E. Line

_____ Ft. from W. Line



Seward County

Location X

Rig up _____

Drilling and Remarks:

RECORD

Cased _____ in., _____ ft.

Sand _____

Gas _____

Oil _____

Total Depth _____

PRODUCTION

1st 24 hrs. Nat. _____

1st 24 hrs. after shot _____

Gas _____ Cu. Ft.

Dry Hole _____

Abandoned _____

Date

AUG 2 1950

J. E. TYRA

Scout

