


DX 78-1 Seward

KANSAS

Section 6 Township 35 Range 33W

Well No. #4 Liberal Airport

Company J. B. Hawley, Jr.

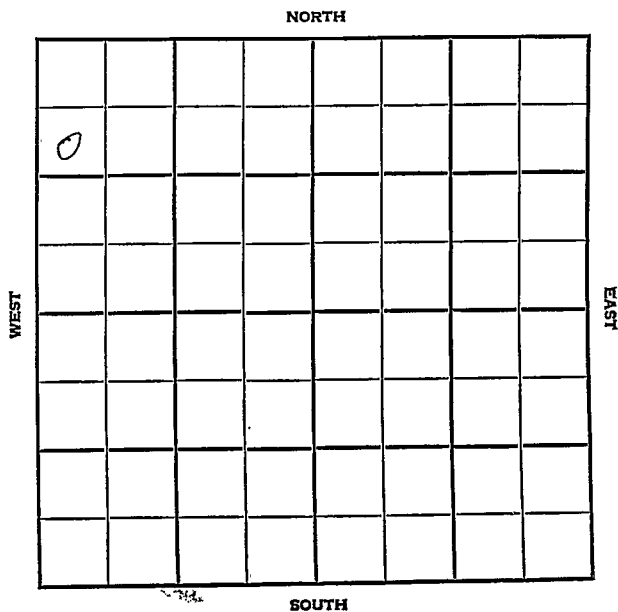

Seward

KANSAS

SEC.

6

TWP.

-35

R.

33W

WELL NO.

#4 Liberal Airport

FARM

COMPANY

J. B. Hawley, Jr.

CONTRACTOR

Garvey


____ FT. FROM N. LINE

____ FT. FROM S. LINE

____ FT. FROM E. LINE

____ FT. FROM W. LINE

SW NW NW

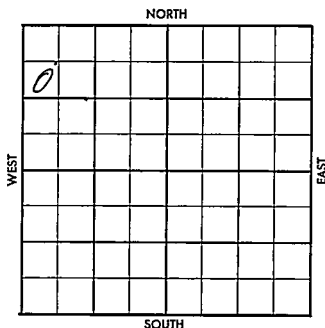

1956

ELEVATION

REPORT

8-1

Location

COMPLETED

[illegible]


TOPS	DEPTH	LOG	DATUM	Loc. in Sec.
Anb.				
TP. <u>Hall</u>	<u>2614</u>			
H. <u>Herr</u>	<u>2641</u>			
Tr. <u>Kr1</u>	<u>2672</u>			
Dg.				
Bl.				
L.				Geol.
K.C.				Contr.
B.K.C.				<u>Convey</u>
Ce.				
C.				Pool
M.				
M.				
K.				
Mz.				
Ma.				
V.				
S.				
S.				
A.				
R.				
PE.				
G.				
T.D.	<u>2725</u>			

COMPLETE
 SEP 2 '56

Date Comm.

Location AUG 18 '56 AUG 15 '56 P-1-5C9" 699/425 5 1/2 @ AUG 22 '562724/700 Co 2722 30d shalebreaks AUG 29 '56 SEP 5 '56 SEP 12 '56 Co 270054/2680-90 50 acid in ga1. Mill CFG. PF 20/2652-571/4 ga 7.860 MCF 13 5.1. 6 hrs1/2 5.1. 14 hrs ga 1.870 MCF1/2 2.150 MCF 1 ga 2.150 MCF

FORM 513-1 SUNRAY

72-209a.7, 175 MCF-
RP 358#