
FORM 51 25M 8-50 WESTERN Meade **KANSAS**

Section 6 Township 35 Range 30W

Well No. #1 A. W. Adams (J)

Company Columbian Fuel

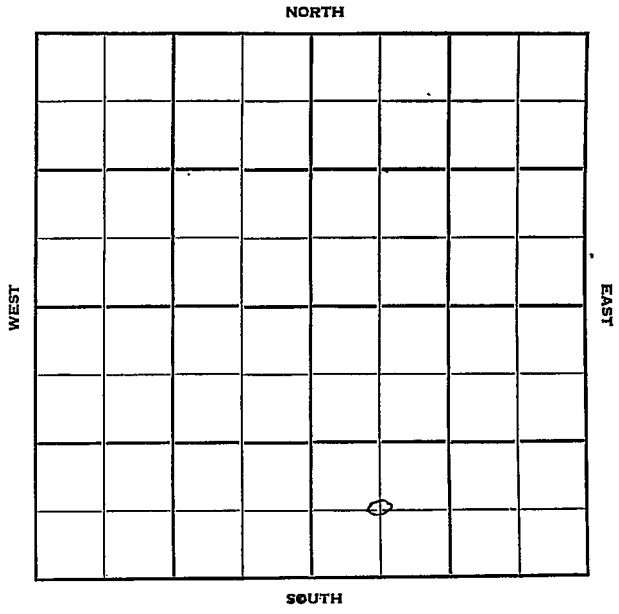

FORM 252-B
10M 8-51 TPCO.

Meade KANSAS

Sec. 6 Twp. 35 R. 30W

Well No. #1 A. W. Adams (J) Farm

Columbian Fuel Company

Adams Ranch Contractor


Ft. from N. Line

660' Ft. from S. Line

Ft. from E. Line

660' Ft. from W. Line

C SW SE

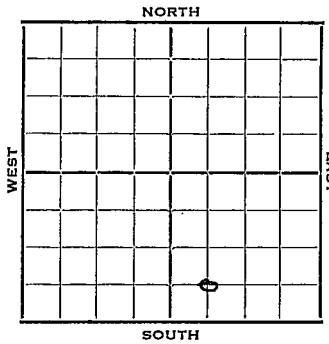

1952	Elev. 2450' REPORT
2/6	Location
2/13	RUR
2/20	13" @ 513 Drlg. 2100'
3/5	Fishing 3593
3/12	Drlg. 4643'
3/19	DST 4362-78, 1 hr, 1890' SGCSW 1250#-15" DST 4876-92, 1 hr, 3240' SGCSW, 1600#-15" DST 4958-73, 1 hr, 2770' SGCSW 1750#-15" Drlg. 5300'
3/25	DST 5428-42', 1/2 hr, 4' M 0# Drlg. 5744'
4/1	Miss li 5766' DST 5761-89' Packer failed. DST 5766-89, 4 hrs, 40 mins, 12,000 gas., 60' GCM, 1300# Drlg. 5980'
4/9	RTD 6100 Sch. 5" @ 5820'
4/23	NR
4/30	NR
5/7	Schl Tops: Krider 2481 Winfield 2540 Up Ft 2604 Low Ft. 2685 Lans. 4230 Marm 5075 Cherokee 5289

OVER

1952 (Information brought forward)

5/7 Atoka 5412 Morrow Shale 5631
Miss 5763 DP 5787
72/5764-76 SSF 500A

5/14 6500 A

5/21 Sq. off set plug 5160' 66/ 511-22
B/ 3 Bw 3 hrs. B/ 15 gal SW & scum
oil set plug 4870 12/ 4860-62
2 BSWPH for 2 hrs. sq. w/20 gal
splastic

5/28 Spud 2-12-52
D&A TD 6100
13" @ 513 8" @ 2450
DST 4362-78 opn 1 hr. Rec. 1890'
sgcsw DST 4876-92 opn 1 hr.
Rec. 3240' sgcsw DST 4958-73 opn
1 hr. Rec. 2770 sgcsw
DST 5428-42 opn ½ hr. Rec. 4' mud
Miss 5766 DST 5761-89 failed
DST 5766-89 opn 4 hrs. 40 min
Rec. 122,000 gas 60' gcm TD 6100
5" @ 5820 Schlumberger Tops:
Kri 2481 Win 2540 Ft. Riley 2604
Lans. 4230 Marm 5075
Cherokee 5289 Atoka 5412
Morrow sh 5631 Miss 5763
DP to 6787 72/6764-76 SSG 500A
SP 5160 66/5111-22 3 bwph
B/15 gsw & scum oil SP 4870
12/4860-62 2 bswph 12/4830-32
60/4848-58 4 bswph

ABANDONED

FORM 275 FOR SALE BY KANSAS BLUE PRINT CO.


County Meade State Kansas

Sec. 6 (Blk. / Twp.) 35 (Sur. / Rge.) 30W Map No.

Operator Columbian Fuel

Well No. 1 Farm A. W. Adams (J)

Elev. Location C SW SE

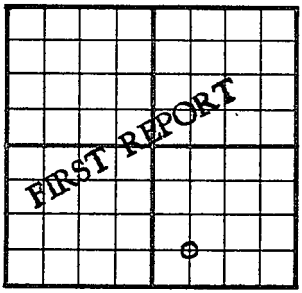

660 Ft. From S Line SE

660 Ft. From W Line Quarter

1st. Report FEB 6 1952

Completion


Remarks

Spudding Date

Drlg. Data Adams Ranch

Location

J. G. McGEHEE

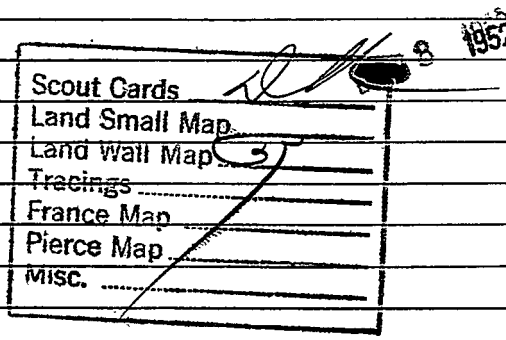
1952
Scout Cards
Land Small Map
Land Wall Map 3
Tracings
France Map
Pierce Map
Misc.

Drlg. Data

FORM 275 FOR SALE BY KANSAS BLUE PRINT CO.


County Meade State Kansas

Sec. 6 (Blk. Twp.) 35 (Sur. Rge.) 30W Map No.

Operator Columbian Fuel

Well No. 1 Farm A. W. Adams "J"

Elev. 2450 Location C SW SE

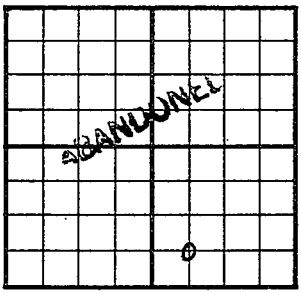

660 Ft. From S Line SE

660 Ft. From W Line Quarter

1st. Report

Completion MAY 28 1952

Remarks Adams Ranch Pool

Spudding Date 2-12-52

Drlg. Data D & A TD 6100

13" @ 513 8" @ 2450 DST 4362-78

open 1 hr. Rec. 1890' sgcsw DST 4876-

92 open 1 hr. Rec. 3240' sgcsw

DST 4958-73 open 1 hr. Rec. 2770' sgcsw

DST 5428-42 open ½ hr. Rec. 4' mud

Miss. 5766 DST 5761-89 failed

DST 5766-89 open 4 hr. 40 min.

Rec. 122,000 gas 60' gcm TD 6100

5" @ 5820 SCHLUMBERGER TOPS

Kri. 2481 Win. 2540 Ft. Riley 2604

Lans. 4230 Marm. 5075 Cherokee 5289

Atoka 5412 Morrow sh. 5631 Miss. 5763

DP to 5787 72/ 5764-76 SSG 500 A

SP 5160 66/ 5111-22 3 bwph

J. G. McGEHEE

Drlg. Data

B/ 15 gsw & scum oil SP 4870

12/ 4860-62 2 bswph 12/ 4830-32

60/ 4848-58 4 bswph

D & A

