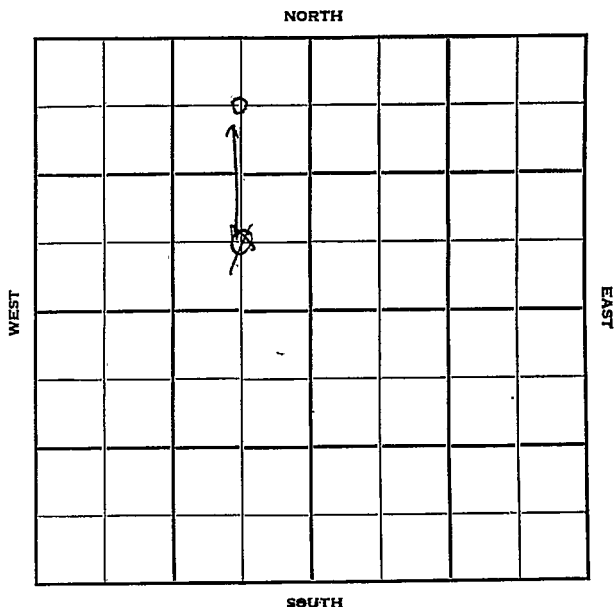


Section 6 Township 35 Range 29 WWell No. # 1 Adams (G)Company Columbian Fuel

Meade


KANSAS 29W

Sec. 6 Twp. 35 R. 29WWell No. #1 Adams (G) FarmColumbian Fuel Company

Contractor

1980' Ft. from N. Line1980' Ft. from S. Line

Ft. from E. Line

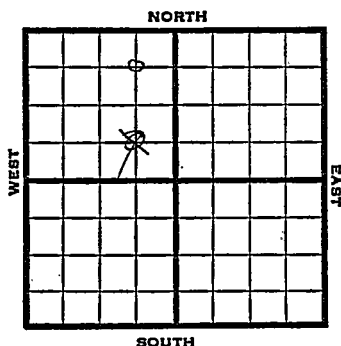1980' Ft. from W. LineC NE NW
G SE NW

1951 Elev. 2511' REPORT

7/11 Location

11/14

Spud 8-12-51

D&A TD 6250

13" @ 626 9" @ 2561

DST 3496-3515 open 1 hr.

Rec. 1278' GCSW & SSO

DST 5129-40 open 1 hr.

Rec. 180' SW 60' SWCM

DST 5246-60 open 1 hr.

Rec. 100' O&GCM 200' oil

1320' SW

DST 5867-5910 open 1 hr.

Rec. 1290' mud

DST 5907-25 open 25 min.

Rec. 1100' mud

DST 5947-83 open 1½ hr.

Rec. 20' mud TD 6250

5" @ 5310 CO to 5277

18/ 5257-60 FU 800' SW

12/ 5254-56 FU 3 BWPH

CO to 5277 24/ 5248-51

10 GO 20 GWPH 16/ 5246-48

16/ 5248-50 2 BWPH 1 goph


Her. 2561 Kri. 2642 Win. 2700

Ft. Riley 2760 Ians. 4462

Marm. 5341 Chester 5957

D&A

ABANDONED

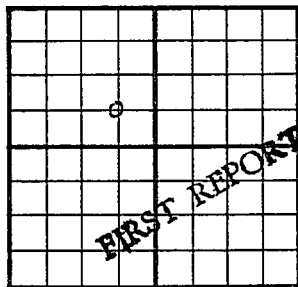County Meade State KansasSec. 6 (Blk. Twp.) 35 (Sur. Rge.) 29W Map No.Operator Columbian FuelWell No. 1 Farm Adams (G)Elev. Location C SE NW1980 Ft. From N Line NW1980 Ft. From W Line Quarter1st. Report JUL 11 1951

Completion

Remarks


Spudding Date

Drig. Data Deep test

Location

J. E. TYRA

County Meade State Kansas
 Sec. 6 (Blk. 35 (Sur. 29W Map No.
 (Twp.) (Rge.)
 Operator Columbian Fuel
 Well No. 1 Farm Adams "G"
 Elev. 2511 Location C NE NW

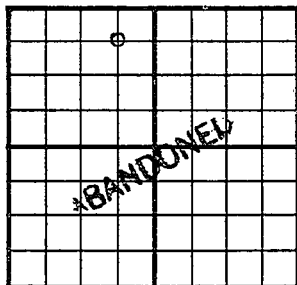

1980 Ft. From S Line NW
1980 Ft. From W Line Quarter

Ist. Report

Completion NOV 14 1951

Remarks

Helmerich & Payne - Contr.

Spudding Date 8-12-51

Drlg. Data D & A TD 6250

13" @ 626 9" @ 2561 DST 3496-3515

open 1 hr. Rec. 1278' gcsw & SSO

DST 5129-40 open 1 hr. Rec. 180' sw

60' swcm DST 5246-60 open 1 hr.

Rec. 100' o & gcm 200' oil 1320' sw

DST 5867-5910 open 1 hr. Rec. 1290' mud

DST 5907-25 open 25 min. Rec. 1100' mud

DST 5947-83 open 1 1/2 hr. Rec. 20' mud

TD 6250 5" @ 5310 CO to 5277 - 18/ 5257-

60 FU 800' sw 12/ 5254-56 FU 3 bwph

CO to 5277 24/ 5248-51 10 go 20 gwph

16/ 5246-48 16/ 5248-50 2 bwph 1 goph

Her. 2561 Kri. 2642 Win. 2700

Ft. Riley 2760 Lans. 4462 Marm. 5341

Chester 5957 D & A

J. E. TYRA

Map No. _____ Sec. 6 Twp. 35 R. 29WWell No. 1 Adams "G"Columbian Fuel

Company

CORRECTION

Contractor

C NE NW

SECTION PLAT

	o		

_____ Ft. from N. Line

1980 Ft. from S. Line

_____ Ft. from E. Line

1980 Ft. from W. LineMeade County

Location _____

Rig up _____

Drilling and Remarks:

Reported

C SE NW

RECORD

Cased _____ in., _____ ft.

Sand _____

Gas _____

Oil _____

Total Depth _____

PRODUCTION

1st 24 hrs. Nat. _____

1st 24 hrs. after shot _____

Gas _____ Cu: Ft.

Dry Hole _____

Abandoned _____

Date

NOV 14 1951

19

J. E. TYRA

Scout