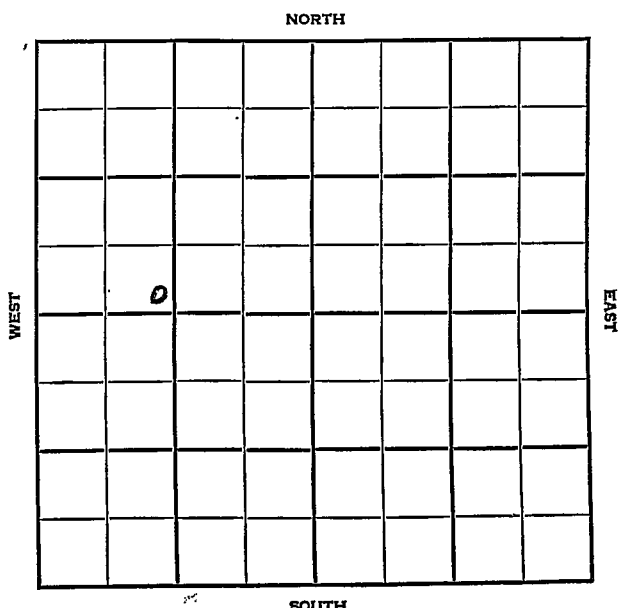


Section 6 Township 35 Range 7WWell No. #1 F. H. McKeeCompany Continental Oil

County Harper Elev. 1310
 Sec. 6 Twp. 35 Rge. 7W
 Company Continental Oil
 Farm Name F. H. McKee No. 1

TOPS	DEPTH	LOG	DATUM	Loc. in Sec.
Anb.				SE SW NW
Tp.				
H.	3564	3574	2164	
Tr.				
Dg.				
BL.				
L.				
K.C.	4154	4162	2852	Geol.
B.K.C.				Contr.
G. <i>Marm</i>	4454		3144	G-M-R
C.	4721		3411	
M. <i>iss</i>	4769	4766	3456	Pool
M.				Wildcat
K.				
Mz. <i>chat</i>		5230	3920	
Me.				
V.	5250	5254	3944	
S.	5303	5298	3988	
S.				
A.		5485	4175	
R.				
Pe.				
G.				
T.D.	5518	5514		

FIRST REPORT
 ABANDONED

Date Comm. 5-5-55 JUN 1 1955

10 3/4" @ 239/350 DST 4765-80

open 1 hr. Rec. 30' mud 0#

DST 4900-15 open 1 hr. Rec. 1700'

muddy sw 2010/20" DST 5295-5305

open 1 hr. Rec. 90' mud 2115/20"

DST 5300-18 open 1 hr. Rec. 2410' sw

2185/20" DST 5347-62 open 1 hr.

Rec. 120' hgcm spk w/ oil 90' wsm 1830#

D & A