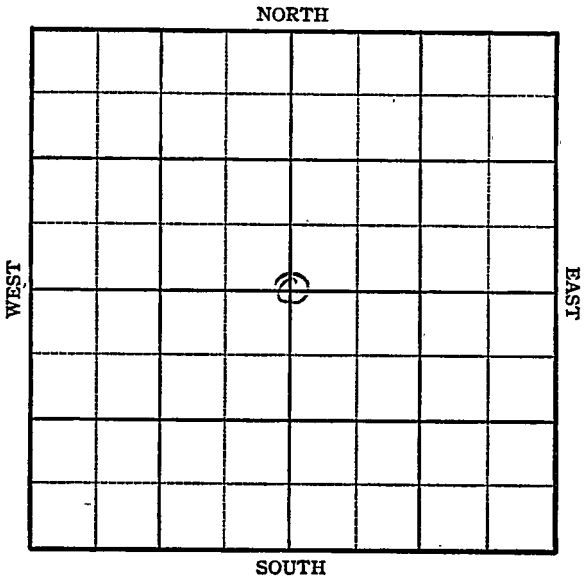


KANSAS

Stevens

FORM 51 5M PETROL

Section 7 Township 35 Range 35WWell No. 1 GoochCompany Texas Skelly

KANSAS

Stevens County

Sec. 7 Twp. 35 R. 35W

Well No. #1 Gooch Farm

Texas Skelly Company

Hugoton


2640 Ft. from N. Line

Ft. from S. Line

2640 Ft. from E. Line

Ft. from W. Line

C Sec.

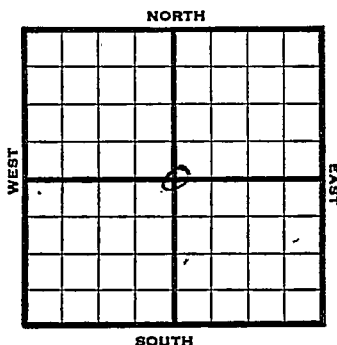

1945 Elev. 3013 REPORT

10/31 RUR

11/7 10" @ 677
Dr1g. 2044

11/14 Dr1g. 2865

11/21 7" @ 2860
TD 2870

234 shots 2783-2822 3000 acid.

11/28 300 shots 2721-2771 1400 acid.

12/5 16,183,000 Gas.

12/12 20,700,000 Gas.

12/19 7" @ 2860
Perf. 18,000 acid.
TD 2870
20,700,000 Gas.

COMPLETED

KANSAS

Kansas Pool Name HugotonMap No. 11 Sec. 7 Twp. 35 R. 35WWell No. 1 Gooch

Texas Skelly


Company

FIRST REPORT

Contractor

C Sec.

SECTION PLAT

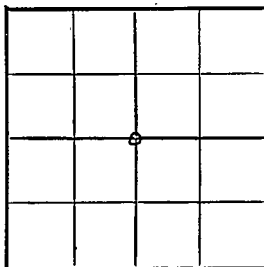2640 Ft. from N. Line Ft. from S. Line2640 Ft. from E. Line Ft. from W. Line

Stevens County

Location Rig up

Drilling and Remarks:

RUR

RECORD

Cased in., ft.Sand Gas Oil Total Depth

PRODUCTION

1st 24 hrs. Nat. 1st 24 hrs. after shot Gas Cu. Ft.Dry Hole Abandoned

Date

OCT 31 1945 19

S. J. LEWIS Scout

KANSAS


Kansas Pool Name HugotonMap No. 1/2 map Sec. 7 Twp. 35 R. 35WWell No. 1 GoochTexas Skelly

Company

COMPLETED

Contractor

C Sec.

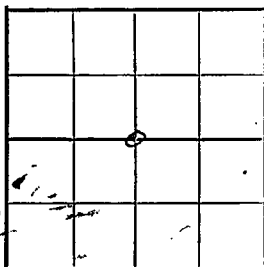E 1/3013
SECTION PLAT2640 Ft. from N. Line Ft. from S. Line2640 Ft. from E. Line Ft. from W. LineStevens CountyLocation Rig up

Drilling and Remarks:

7" C 2860Perf.18000 acid20,700,000 Gas**RECORD**Cased in., ft.Sand Gas Oil Total Depth 2870**PRODUCTION**1st 24 hrs. Nat. 1st 24 hrs. after shot Gas Cu. Ft.Dry Hole Abandoned

Date

DEC 1 9 1945 19S. J. LEWIS Scout