


Section 7 Township 35 Range 34W

Well No. #1 Guy Speakman

Company Plains Natural Gas

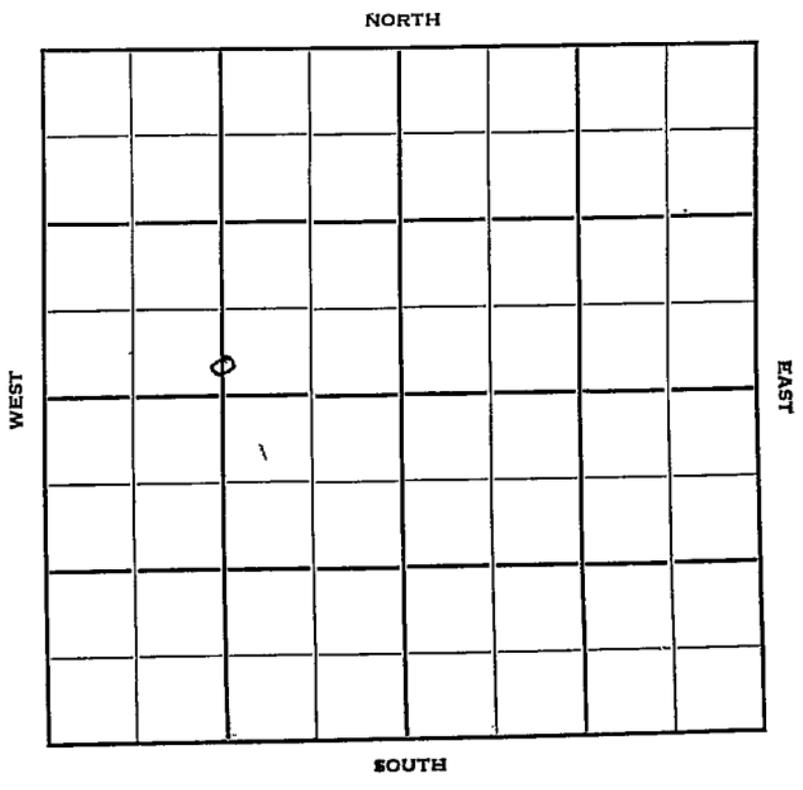

Sec. 7 Twp. 35 R. 3/W

Well No. #1 Guy Speakman Farm

Plains Natural Gas Company

Contractor

Hugoton Pool


2440' Ft. from N. Line

_____ Ft. from S. Line

_____ Ft. from E. Line

1320' Ft. from W. Line

C S L S $\frac{1}{2}$ NW

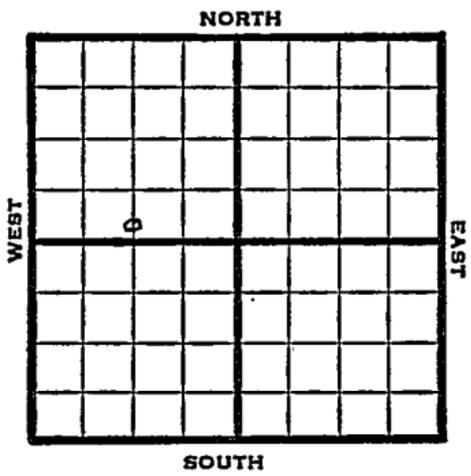

1950

Elev 2968 REPORT

10/4

Location

11/22

Spud 10-14-50

10" @ 636

7" @ 2767

TD 2772

Hol 2616

Her 2681

Krider 2715

120/2744-64, 30/2724-29, 30/2716-21

120/2682-2702 18000 A

Comp 1,010,000 gas

Completed

COMPLETED.

County Seward State Kansas

Sec. 7 (Blk. Twp.) 35 (Sur. Rge.) 34W Map No.

Operator Plains Natural Gas

Well No. 1 Farm Guy Speakman

Elev. 2968 Location C S L S $\frac{1}{2}$ NW

2440Ft. From N Line NW

1320Ft. From W Line Quarter

Ist. Report

Completion NOV 22 1951

Remarks Hugoton Pool

Spudding Date 10-14-50

Drlg. Data Gas well TD 2772

10" @ 636 7" @ 2767 TD 2772

Hol. 2616 Her. 2681 Krider 2715

120/ 2744-64 30/ 2724-29 30/ 2716-21

120/ 2682-2702 18000 A

Comp. 1,010,000 gas

J. E. TYRA