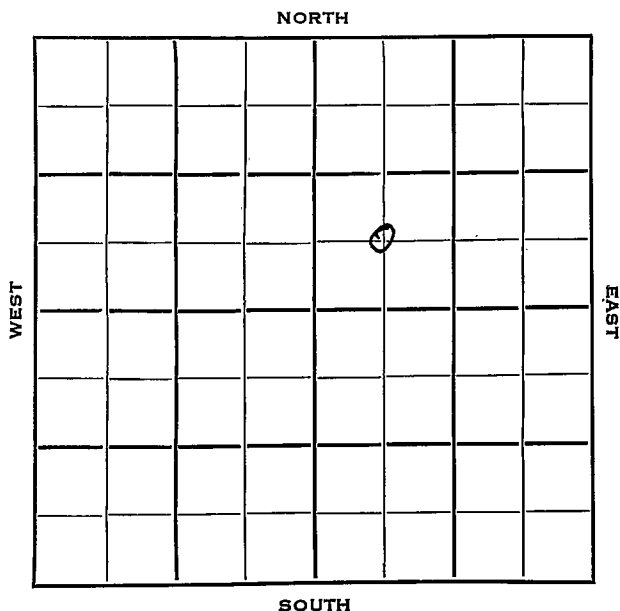


Section 7 Township 35 Range 31WWell No. 1 BatyCompany Huber Corp.

Seward KANSAS

SEC.	TWP.	R.
7	35	31 W

WELL NO.

1 Baty

FARM

COMPANY

Huber Corp.

CONTRACTOR

Huber

Light Pool


Ft. from N. Line.

660 Ft. from S. Line

Ft. from E. Line

660 Ft. from W. Line

C SW NE

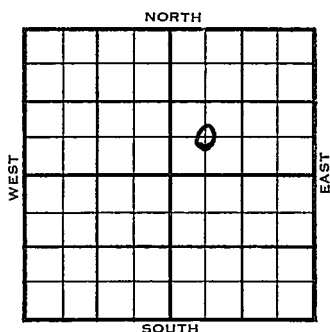

1953

ELEVATION

2710'

REPORT

11/4

Location

12/9

Drlg. 4440'

12/16

Drlg 5160'

1954

1/6

D & A

1/20

Spud 11-17-53

D&A

TD 6320'

13" @ 600

9" @ 2400'

DST 5961-6061', failed

DST 6043-61', opn 1 hr., rec. 155'

vsgcm

DST 6103-62', opn 1 hr., rec. 90' mud,

TD 6320'

Kri 2701', Win 2777', Ft. Riley 2834',

Lans 5413', Morrow 5937', Chester

5194'

D&A

ABANDONED

J. G. McGEHEE


Scout Cards	<i>mm</i>
Land Small Map	
Land Wall Map	<i>63</i>
Treasure	
French Map	
Picard Map	
Misc.	

NOV

6 1933

Orig. Date

County Seward State Kansas
 Sec. 7 (Blk. 35 (Sur. 31W Map No.
 (Twp.) (Rge.)
 Operator Huber Corp.
 Well No. 1 Farm Baty
 Elev. 2710 Location C SW NE

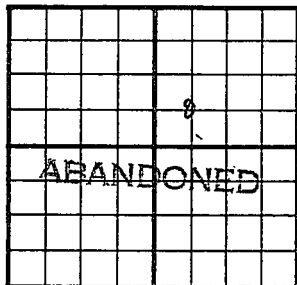

660 Ft. From S Line NE
660 Ft. From W Line Quarter

1st. Report

Completion JAN 20 1954

Remarks Light Pool

Huber - Contr.

Spudding Date 11-17-53

Drlg. Data D & A TD 6320

13" @ 600 9" @ 2400 DST 5961-6061

failed DST 6043-61 open 1 hr.

Rec. 155' vsgcm DST 6103-62 open 1 hr.

Rec. 90' mud TD 6320

Kri. 2701 Win. 2777 Ft. Riley 2834

Lans. 5413 Morrow 5937 Chester 5194

D & A

J. G. McGEHEE

JAN 27 1954

Scout Cards	12
Land Small Map	
Land Wall Map	3
Troopings	
France Map	
Pierce Map	
Misc.	

Drig. Data