

Meade


KANSAS

SECTION 7 TOWNSHIP 35S RANGE 28W

WELL NO. #1 A.J. Merkle

COMPANY Sinclair O&G

NORTH C SW NW

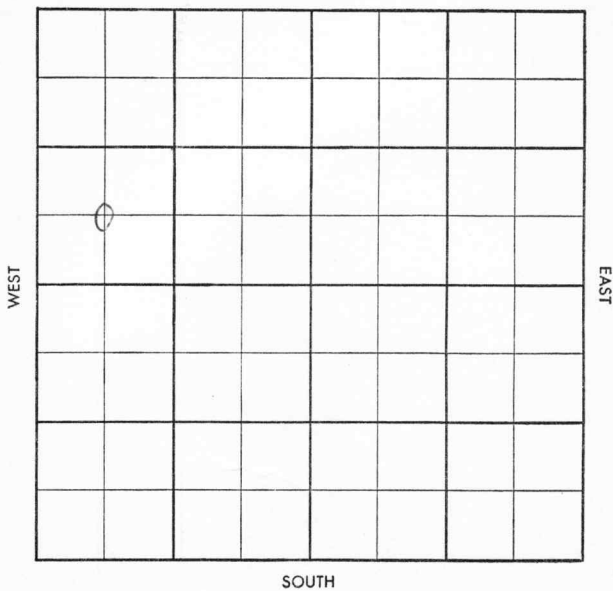

Twp. X Pool X
 Co. X Facet 23

S-513-B

County Meade Elev. _____
 Sec. 7 Twp. 35 Rge. 2 SW
 Company Sinclair O & G
 Farm Name A. J. Merkle No. 1

TOPS	DEPTH	LOG	DATUM
Anh.			
Tp.			
H.			
Tr.			
Dg.			
B. L.			
L.			
K. C.			
B. K. C.			
Ce.			
C.			
M.			
M.			
K.			
Mz.			
Mq.			
V.			
S.			
S.			
A.			
R.			
Pf.			
G.			
T. D.			

Loc. in Sec. _____
C SW NW
6300' test
 Geol. _____
 Contr. _____
D & M Drlg.
 Pool _____
Adams Ranch



Date Comm. _____
Location

Co.
 Lse.
 No.
 Sec.
 T.
 R.

MEADE COUNTY

KANSAS

7-35-28

Well: SINCLAIR O&G CO. #1 Merkle

Result: D&A

Loc'n: 7-35-28, C SW NW, Adams Ranch Fl'd.

Spud: 8-8-58; Comp: 9-16-58; Elev: 2391' RB; TD: 6212'

Casing: 20" 58', 13" 605', 8" 2495'

Prod Zone: None

IP: None

Comp Info: DST 5936-60', op 3 hrs, rec 20' mud, BHP 275~~5~~; DST 6012-67', op 3 hrs, rec 28' mud, BHP 1720~~5~~,

Tops: Kri 2638', Winf 2692', Tow 2770', Ft. Riley 2830',

Tor 4460', Lans 4597', Marm 5293', Morr 5860', Miss Chest 5994'.

Geo Associates
OIL REPORTS

Date: 9-26-58

Card No.: 4 Kan pc

Twp. _____ Foot _____
 Co. _____ Facet _____

S-513-B

County Meade Elev 23916L 23971
 Sec. 7 Twp. 35 Rge. 2 SW
 Company Sinclair O & G
 Farm Name A. J. Merkle No. 1

TOPS	DEPTH	LOG	DATUM
Anh. <u>Krid</u>	<u>2638</u>	<u>2638</u>	
Tp. <u>win</u>	<u>2692</u>	<u>2696</u>	
H. <u>70 W</u>	<u>2770</u>	<u>2772</u>	
Tr. <u>ET Riley</u>	<u>2930</u>	<u>2830</u>	
Dg. <u>Cammil</u>	<u>2990</u>		
B.L.			
L.			
K.C.			
B.K.C.			
Ce.			
C. <u>TR</u>	<u>4460</u>	<u>4466</u>	
M. <u>LKC</u>	<u>4597</u>	<u>4618</u>	
M. <u>marm</u>	<u>5293</u>		
K.			
Mz.			
Mq.			
V.			
S. <u>mor</u>	<u>5863</u>	<u>5860</u>	
S. <u>mor sd</u>	<u>5949-57</u>		
A. <u>Chester</u>	<u>5997</u>	<u>5994</u>	
R.			
Pf.			
G.			
T.D.	<u>6216</u>	<u>6212</u>	

Loc. in Sec. _____
C SW 1/4
6300' test
 Geol. _____
 Contr. _____
D & M Drlr.
 Pool _____
Adams Ranch

ABANDONED

Date Comm. 8-8-58 20" 58/100
 Location AUG 13 '58 1339 605/500
661 AUG 20 '58 8 5/4 2496/500 woc
AUG 27 '58 6 SEP 3 '58 65465 SEP 10 '58 DST
5936-60 3hr 20'M FP35-35
BHP 155-275 DST 6012-67 3hrs
28'M FP 3550 BHP 1700-1720
woc SEP 17

DBA