

Section 8 Township 35 Range 40WWell No. #1 Goddard "A"Company Cities Service

NORTH

				0			

WEST

EAST

SOUTH

Morton

KANSAS

Sec. 8 Twp. 35 R. 40W

Well No. #1 Goddard "A" Farm ☒

Cities Service

Company

Contractor

Hugoton Pool


100' Ft. from N. Line

Ft. from S. Line

Ft. from E. Line

100' Ft. from W. Line

NW SE

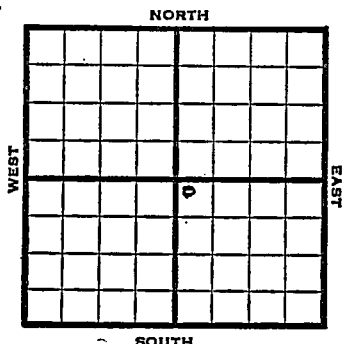

1951

Elev. 3412' REPORT


2/28

Spud 2-24-51
8" @ 320
Drlg. 1955'

4/4


Spud 2-24-51
Gas Well TD 2750'
8" @ 320 5" @ 2749
TD 2750
Krider 2524-44 Win. 2596-2630
Ft. Riley 2670-96
130/2670-96 1500 A
Test sw SP 2651
30/2624-30
100/2596-2616 130/2550-76
50/2534-44 30/2534-30 24,500 A
Comp. 15,800,000 gas 418#

COMPLETED

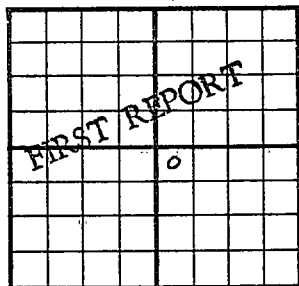County Morton State KansasSec. 8 (Blk. 35) (Sur. 40W) (Twp. Map No.)Operator Cities ServiceWell No. 1 Farm Goddard "A"Elev. NW SE Location100 Ft. From N Line SE100 Ft. From W Line Quarter1st. Report FEB 28 1951Completion Remarks Spudding Date 2-24-51Drlg. Data Hugoton Pool8" @ 320 drlg. 1955

J. E. TYRA

County Morton State Kansas
 Sec. 8 (Blk.) 35 (Sur.) 40W Map No.
 Operator Cities Service
 Well No. 1 Farm Goddard "A"
 Elev. 3412 Location NW SE

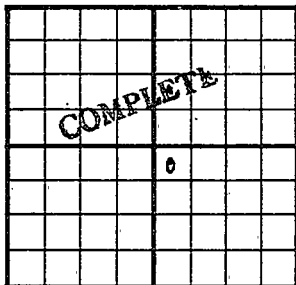

100 Ft. From N Line SE
100 Ft. From W Line Quarter
 1st. Report
 Completion APR 4 1951
 Remarks Hugoton Pool
 Spudding Date 2-24-51

Drlg. Data Gas well TD 2750
8" @ 320 5" @ 2749 TD 2750
Kridler 2524-44 Win. 2596-2630
Ft. Riley 2670-96 130/ 2670-96 1500 A
test sw SP 2651 30/ 2624-30
100/ 2596-2616 130/ 2550-76 50/ 2534-44
30 / 2534-30 24500 A
Comp. 15,800,000 gas 418#