


Section 8 Township 35 Range 12W
Well No. #1 Achenbach
Company Aurora Gasoline

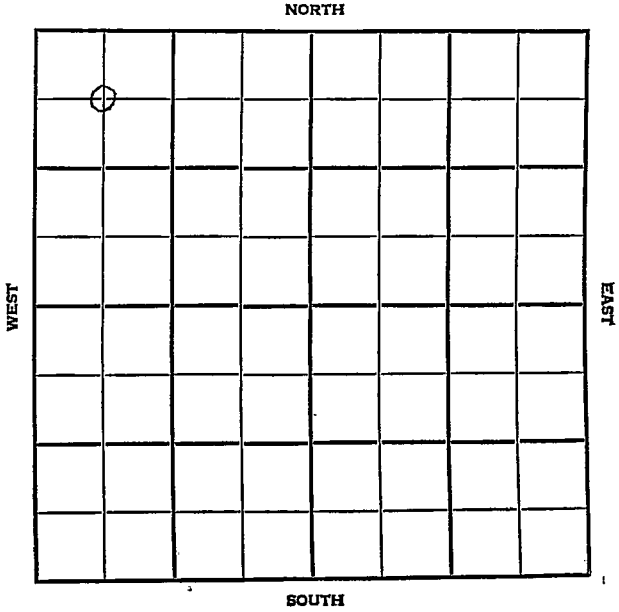

Barber

KANSAS

SEC.

8

TWP.

35

R.

12W

WELL NO.

#1 Olsen "C"
#1 Achenbach

FARM

COMPANY

Aurora Gasoline

CONTRACTOR

Barbour

Hardtner


____ FT. FROM N. LINE

____ FT. FROM S. LINE

____ FT. FROM E. LINE

____ FT. FROM W. LINE

C NW NW

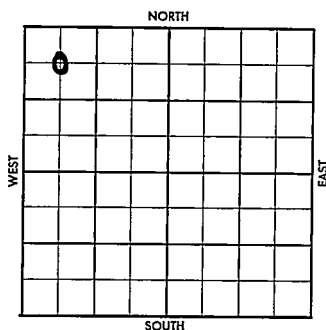

1956

ELEVATION

REPORT

8-22

Comm. 8-20-56
8" @ 250 w/250
Drlg. 460

ABANDONED

County Barber Elev. _____
 Sec. 8 Twp. 35 Rge. 12W
 Company Aurora Gasoline
 Farm Name Achenbach No. 1

TOPS	DEPTH	LOG	DATUM	Loc. in Sec.
Anh.				<u>G NW NW</u>
Tr.				
H.				
Tr.				
Dg.				
Bl.				
L.				Geol. _____
K.C.				Contr. _____
B.K.C.				<u>Barbour</u>
Ce.				
C.				Pool _____
M.				<u>Hardtner</u>
M.				
K.				
Mz.				
Mo.				
V.				
S.				
S.				
A.				
R.				
Pe.				
G.				
T.D.				

0		

FIRST REPORT

Date Comm. 8-20-56

AUG 22 '56

8" @ 250/250 d rlg. 460

2501 S 20A

CORRECTION

FORM 513 SUNRAY

County Barber Elev. 1415 D.F.
 Sec. 8 Twp. 35 Rge. 12W
 Company Aurora Gasoline
 Farm Name Achenbach Olsen "C" No. 1

TOPS	DEPTH	LOG	DATUM	Loc. in Sec.
Anb.				10 NW NW
Tp.				
H.				
Tr.				
Dg.				
Bl.				
L.				Geol.
K.C.				Contr.
B.K.C.				Barbour
Ce.	4750-70			Pool
C.	4780			Hardtner
M.	4805 4798			
M.				
K.	5208			
Mz.				
Ma.				
V.	5266			
S.				
S.				
A.				
R.				
PE.				
G.				
T.D.	5304			

ABANDONED

SEP 12 '56

Date Comm. 8-20-56

8" @ 250/250 d rlg. 460

AUG 26 56

1) 3380 SEP 5 '56 DST 4750-71
 2 hrs @ 15" rec 129' V50 E 6 CM
 BHP 305/30" DST 4796-4835
 3 hrs @ 133" rec 250' V50 E 6 CM
 BHP @ 525/45" @ 4835 W.O.O.
 SEP 12 '56 DST 5196-5220 1 hr rec
 30' Md BHP 96 DST 5198-5235
 70" rec 3300' DST 5605W BHP 400
 D.E.A.