

Morton

KANSAS

9

35

42W

SECTION \_\_\_\_\_ TOWNSHIP \_\_\_\_\_ RANGE \_\_\_\_\_

#1-9 Wares


WELL NO. \_\_\_\_\_

P.E.P.L.

COMPANY \_\_\_\_\_

NORTH

C NE/4

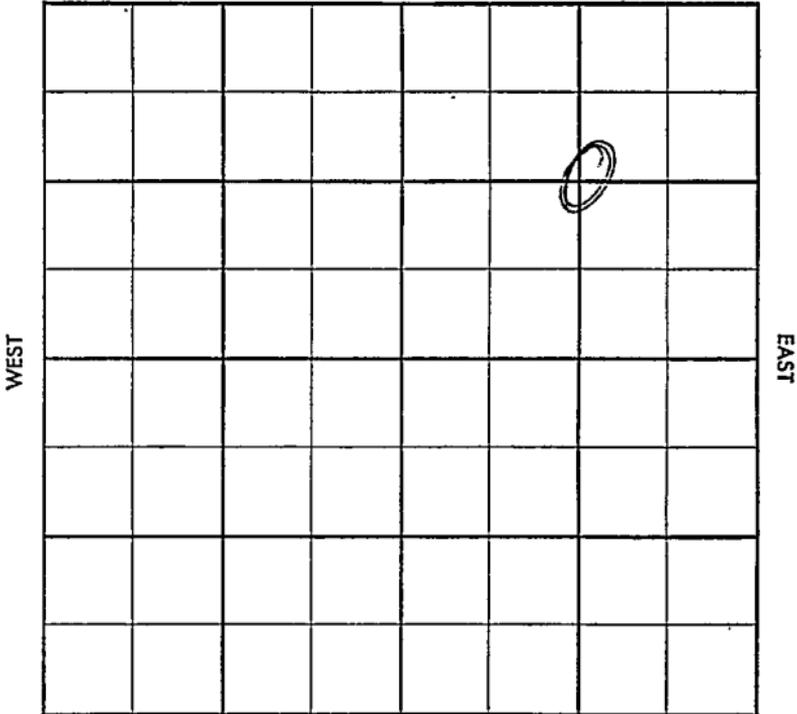

SOUTH

WEST

EAST



