

Morton

FORM 51 25M 3-49 PETROL

KANSAS

Section 9 Township 35 Range 41W


Well No. #1 Howard (B)

Company Cities Service Oil

NORTH

WEST

EAST

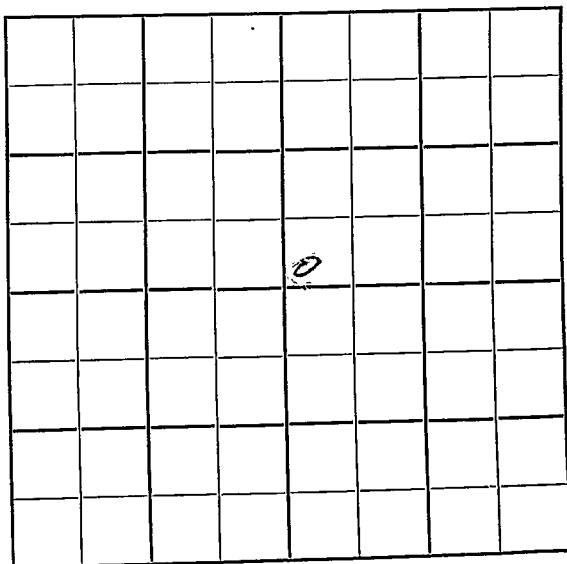

SOUTH

Morton KANSAS

Sec. 9 Twp. 35 R. 41 W

Well No. # 1 Howard (B) Farm

Cities Service Oil Company

Contractor


Ft. from N. Line

100 Ft. from S. Line

Ft. from E. Line

100 Ft. from W. Line

SW SW NE

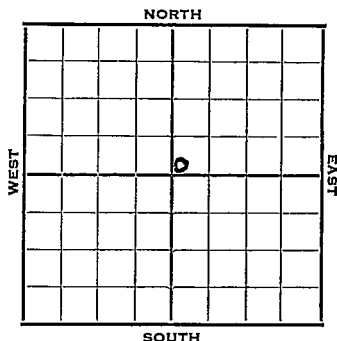

1952 Elev. 3509' REPORT

7/16 Location
7/23 8" @ 360'
Drlg. 1295'
7/30 TD 2365' 5" @ 2364
Krider 2248 Win 2306
8/6 NR
8/13 CO 2348 20/ 2342-46 35/ 2328-35
90/2306-24 2000 A
8/20 6000 A 80/2280-96 20/2370-74
30/2260-66 7000 A
8/27 6000 A
9/3 NR
9/10 Spud 7-19-52
Gas Well TD 2365' 8" @ 360'
Kri. 2248 Win. 2306
TD 2365' 5" @ 2364' CO to 2348
20/ 2342-46 35/ 2328-35
90/ 2306-24 2000 A 175,000 gas
6000 A 80/ 2280-96 20/ 2370-74
30/ 2260-66 7000 A 18000 A total
Comp. 2,330,000 gas


COMPLETED

County Morton State Kansas
 Sec. 9 (Blk. 35) (Sur. 41W) Map No.

Operator Cities Service

Well No. 1 Farm Howard "C"

Elev. 3509 Location SW SW NE

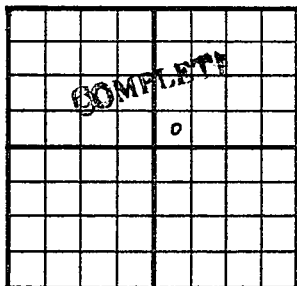

100 Ft. From S Line NE

100 Ft. From W Line Quarter

1st. Report

Completion SEP 10 1952

Remarks

Spudding Date 7-19-52

Drig. Data Gas well TD 2365

8" @ 360 Kri. 2248 Win. 2306

TD 2365 5" @ 2364 CO to 2348

20/ 2342-46 35/ 2328-35 90/ 2306-24

2000 A 175,000 gas 6000 A

80/ 2280-96 20/ 2370-74 30/ 2260-66

7000 A 18000 A total

Comp. 2,330,000 gas