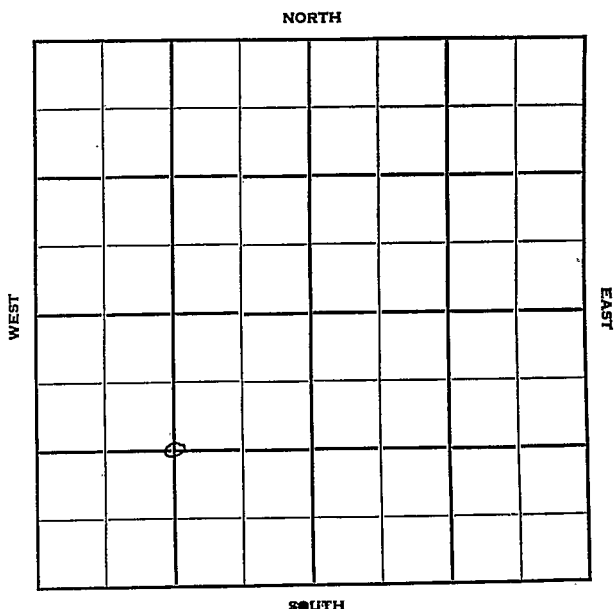


Section 9 Township 35 Range 38WWell No. #1 BrecheisenCompany Ballard et al

Stevens

KANSAS

Sec. 9 Twp. 35 R. 38 W

Well No. # 1 Brecheisen Farm 1

Ballard et al Company

Contractor


Ft. from N. Line

1320 Ft. from S. Line

Ft. from E. Line

1320 Ft. from W. Line

C SW/4

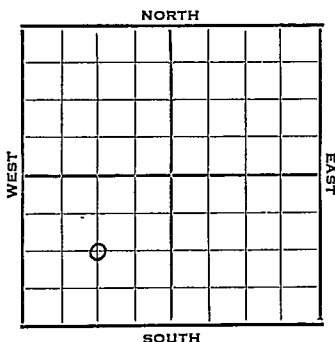

1951 Elev. ³²¹⁶~~3226~~ REPORT

12/5 Spud 11-26-51
8" @ 700
Drlg. 2545'

1952
1/9 Spud 11-26-51
Gas well TD 2829
8" @ 700
Hol. 2580 Kri. 2670
Win. 2745 Ft. Riley 2806
TD 2810 5" @ 2808 DD 2829
24/ 2654-60 228/ 2675-2732
24/ 2739-45 136/ 2748-82
2000 A
Comp. 19,049,000 gas

COMPLETED

County Stevens State Kansas
 Sec. 9 (Blk.) 35 (Sur.) 38W Map No.
 Operator Ballard et al.
 Well No. 1 Farm Brecheisen
 Elev. 3226 Location C SW/4


FIRST REPORT

1320 Ft. From S Line SW
1320 Ft. From W Line Quarter
 Ist. Report DEC 5 1951
 Completion _____
 Remarks _____
 Spudding Date 11-26-51

Drlg. Data

8" @ 700 drlg. 2545

J. E. TYRA

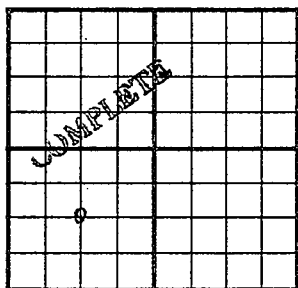County Stevens State KansasSec. 9 (Blk. Twp.) 35 (Sur. Rge.) 38W Map No.Operator Ballard et al.Well No. 1 Farm BrecheisenElev. 3216 Cor. Location C SW/41320 Ft. From S Line SW1320 Ft. From W Line Quarter

1st. Report

Completion JAN 9 1952

Remarks

Spudding Date 11-26-51Drilg. Data Gas well TD 28298" @ 700 Hol. 2580 Kri. 2670Win. 2745 Ft. Riley 2806 TD 28105" @ 2808 DD 2829 24/ 2654-60228/ 2675-2732 24/ 2739-45136/ 2748-82 20000 AComp. 19,049,000 gas

J. E. TYRA