


Section 9 Township 35 Range 3 W

Well No. # 1 Hudson

Company Magnolia

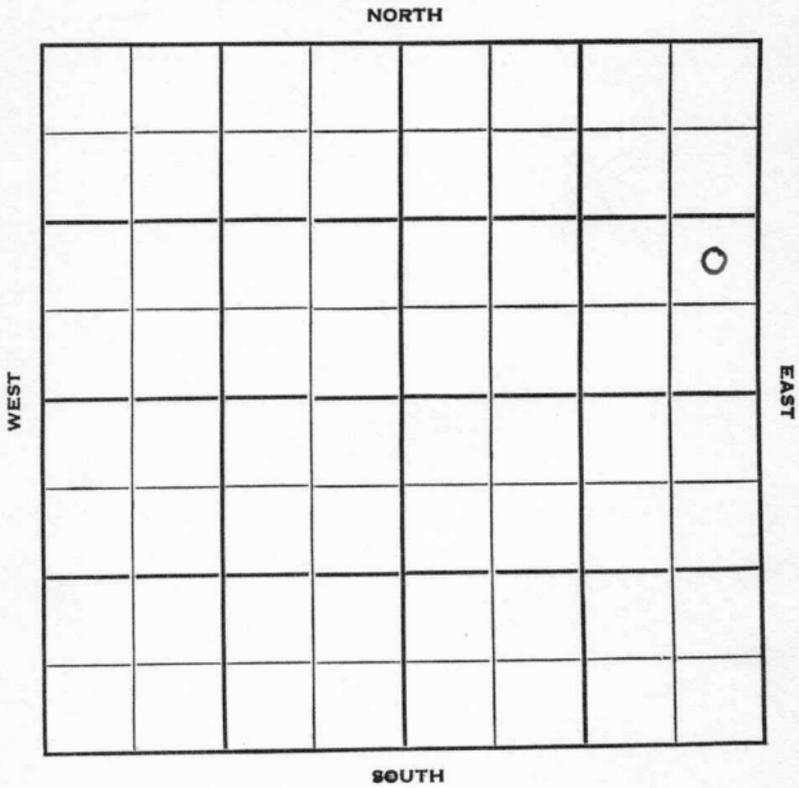

Summer

KANSAS



Sec. 9 Twp. 35 R. 3W

Well No. #1 Hudson Farm

Magnolia Company

Contractor

Full Creek Pool


Ft. from N. Line

990' Ft. from S. Line

330' Ft. from E. Line

Ft. from W. Line

NE SE NE

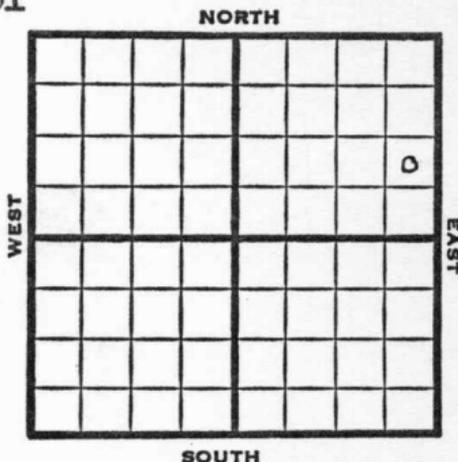

1951 Elev. 1124' REPORT

3/14 Location

5/29 Spud 3-18-51  
 Oil Well TD 4801  
 8" @ 605 Layton 3592  
 KC 3647  
 DST 3686-3705 opn 1½ hr  
 Rec. 100' socm  
 Miss 4349 B Miss 4695 Viola 4758  
 Simp 4769 SO 4769-72 4773-75  
 DST 4782-92 opn 1 hr gas in 11 min.  
 Rec. 650' clean oil 30' mud  
 Simp sd 4782 TD 4791  
 5" @ 4782 14/4783-91 1000 A  
 F/348 bo 19 hr 2000 A F/350 bo  
 12 hr. SP 4778 64/4768-77 CO to 4801  
 F/33 boph Comp. draw down pot.  
 2036 bopd

**COMPLETED**


County Sumner State Kansas

Sec. 9 (Blk.) 35 (Sur.) 3W Map No.

Operator Magnolia

Well No. 1 Farm Hudson

Elev. \_\_\_\_\_ Location NE SE NE

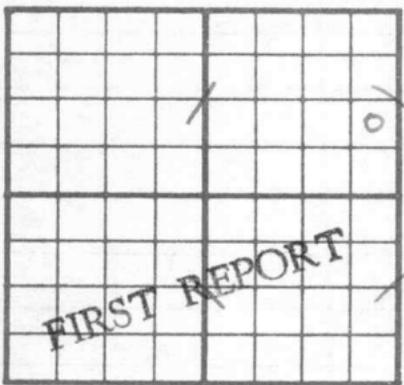

990 Ft. From S Line NE

330 Ft. From E Line Quarter

Ist. Report MAR 14 1951

Completion \_\_\_\_\_

Remarks \_\_\_\_\_

Spudding Date \_\_\_\_\_

Drlg. Data Fall Creek Pool

Location

J. E. TYRA

Scout Cards .....	<i>SM</i>
Land Small Map .....	
Land Wall Map .....	<i>5</i>
Tracings .....	
France Map .....	
Pierce Map .....	
Misc. ....	

MAR 16 1951

County Sumner State Kansas

Sec. 9 (Blk. 35) (Sur. Rge.) 3W Map No.

Operator Magnolia

Well No. 1 Farm Hudson

Elev. 1124 Location NE SE NE


990 Ft. From S Line NE

330 Ft. From E Line Quarter

Ist. Report

Completion MAY 29 1951

Remarks Fall Creek Pool

Spudding Date 3-18-51

Drlg. Data Oil well TD 4801

8" @ 605 Layton 3592 KC 3647

DST 3686-3705 open 1 1/2 hr. Rec. 100' socm

Miss. 4349 B Miss. 4695 Viola 4758

Simp. 4769 SO 4769-72 4773-75

DST 4782-92 open 1 hr. gas in 11 min.

Rec. 650' clean oil 30' mud Simp. sd.4782

TD 4791 5" @ 4782 14/ 4783-91 1000 A

F/ 348 bo 19 hr. 2000 A F/ 350 bo

12 hr. SP 4778 64/ 4768-77 CO to 4801

F/ 33 boph Comp. draw down pot. 2036 bopd.

J. E. TYRA

Scout Cards .....
Land Small Map .....
Land Wall Map .....
Tracings .....
France Map .....
Pierce Map .....
Misc. ....

JUN 4 1951