


Section 9 Township 35 Range 3 W

Well No. # 3 Hudson

Company Magnolia Petroleum

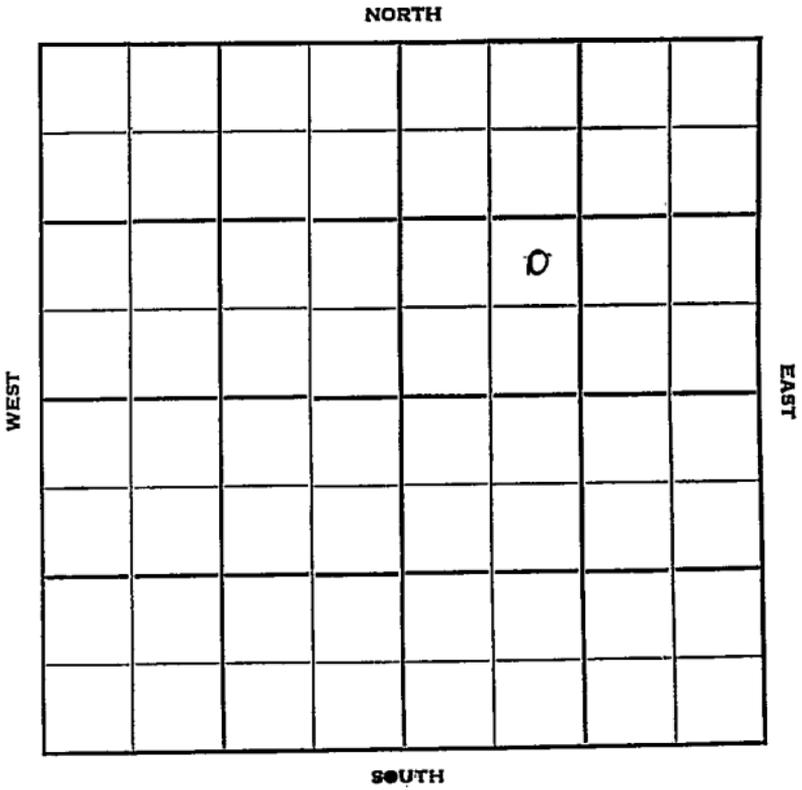

# HOT FILE Summer

KANSAS


Sec. 9 Twp. 35 R. 3W

Well No. #3 Hudson Farm

Magnolia Petroleum Company

Barnett - Contr. Contractor

Fall Creek - Pool

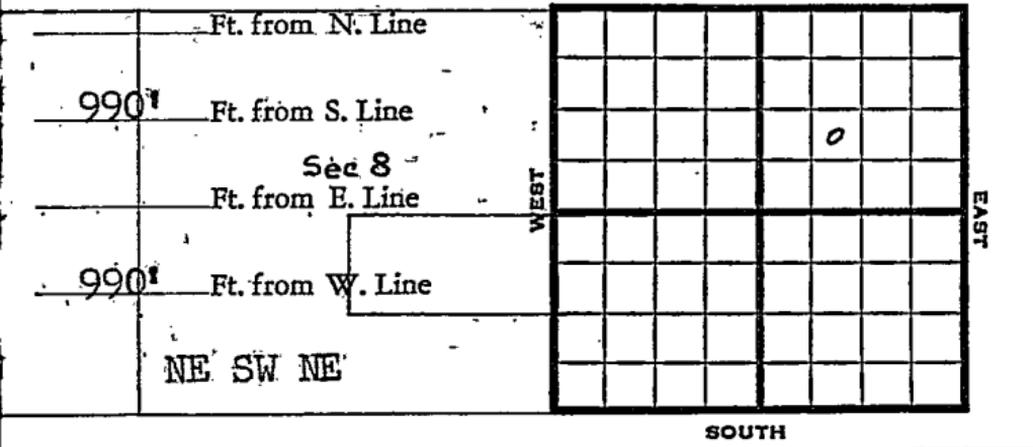

1951 Elev. 1126' REPORT

6/27 RUR

7/19 Spudded 6-28-51  
8" at 611'  
KC 3669'  
Miss. 4354'  
DST. 4356'-80' - open 1 1/4 hr.  
Rec. 180' slightly oil & gas cut mud  
FP 175#  
BHP. 1700#  
Drilling ahead. (L R)

7/26 Drilling 4655'. "

8/1 Base Miss. 4693'  
Viola 4767'  
Simpson 4776'  
DST. 4790'-4818' - open 20 minutes  
Gas in 6 minutes  
flowed oil in 13 minutes  
Shut in BHP. 1590#  
RTD. 4818'  
5 1/2" at 4818'  
WOC. "

8/10 Cleaned out to 4814'  
24/ 4780'-86' 75/ 4780'-4810'  
36/ 4810'-16' 15/ 4815'-4818'  
S & F 289 BO in 11 hrs.

8/20 No water, testing. "  
Comp. for a BHB potential of 1722 "  
bopd. "

**OVER**

1951

8/15 Spud 6-28-51  
Oil Well TD 4818  
8" @ 611'  
KC 3669  
Miss 4354  
DST 4356-80 opn 1 $\frac{1}{2}$  hr.  
Rec. 180' so & hgem  
B. Miss 4693 Viola 4767  
Simp 4776  
DST 4790-4818 opn 20 min. gas in  
6 min.  
Flowed oil 13 min.  
TD 4818 5" @ 418  
CO to 4814  
24/4780-86 75/4795-4810 36/4810-16  
15/4815-18 S & F/289 bo 11 hr.  
Comp. BHB 1722 bopd

**COMPLETED**

County Sumner State Kansas

Sec. 9 (Blk. Twp.) 35 (Sur. Rge.) 3W Map No.

Operator Magnolia Petroleum

Well No. 3 Farm Hudson

Elev. Location NE SW NE

FIRST REPORT	
	0

990 Ft. From S Line NE

990 Ft. From W Line Quarter

1st. Report JUN 27 1951

Completion

Remarks ( $\frac{1}{2}$  mile from MCPC)

Barnett - Contr.

Spudding Date

Drlg. Data Fall Creek - pool

AUR

JUL 2 1951

Southern Cards	JK
Land Small Map	
Land Wall Map	3
Drawings	
France Map	
Pierce Map	
Misc.	



Scout Cards .....  
Land Small Map.....  
Land Wall Map .....  
Tracings .....  
France Map .....  
Pierce Map .....  
Misc. ....

AUG 27 1951