
FORM 51 25M 3-49 PETROL Sumner KANSAS

Section 9 Township 35 Range 3W

Well No. #4 Hudson

Company Magnolia

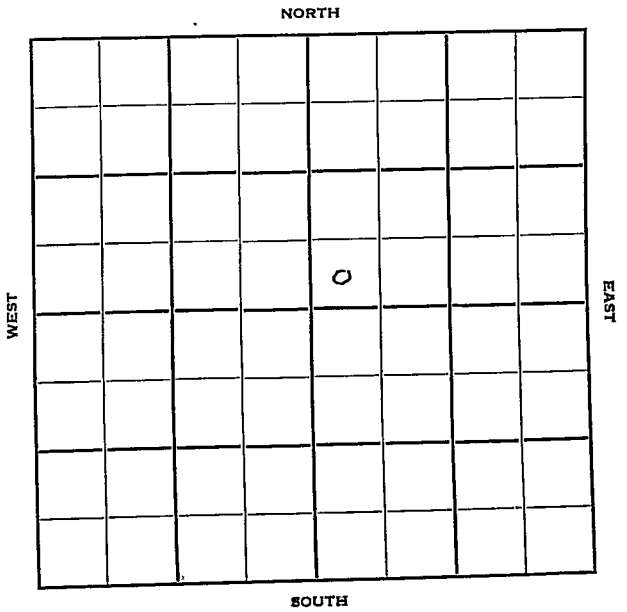

FORM 252-B
10M 11-50 PETROL

Sumner


Sec. 9 Twp. 35 R. KANSA 3W

Well No. #4 Hudson Farm

Magnolia Company

Contractor

Fall Creek Pool

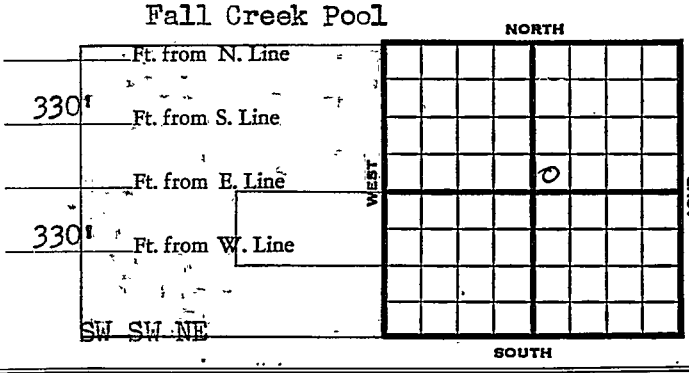

1951	Elev. 1130' REPORT
8/8	Location
8/20	Spudded 8-13-51 8" at 615'. (L R)
8/24	Drilling 2740'. "
8/31	Layton 3629' DST. 3629'-38' - open 40" Rec. 130' mud KC 3682' Drilling 3925'. (L R)
9/10	Miss. 4372' Drilling 4550'. "
9/14	B. Miss. 4715' Viola 4798' Simp. 4806' Cored 4806'-26' - Rec. 20' lime wiht show oil DST. 4803'-26' - open 1 hr. Rec. 30' slightly gas cut mud. Drilling ahead. "
9/21	DST. 4822'-34' - open 1 hr. Rec. 70' oil & gas cut mud DST. 4830'-42' - open 1 hr. Rec. 35' gas cut mud DST. 4842'-50' - open 1 hr. Rec. 15' mud Drilling 4894'1 "

OVER

1951

9/27 Arb. 5034'
DST. 5036'-83' - open 1 hr.
Rec. 602' salt water
Drilling 5137'. (L R)

11/2 TD 5166'. Set 5" @ 5064'
32/4808-16, 64/4828-44,
3000 A, S/6½ BO plus 31 BW,
S/10 BO plus 73 BW in 9 hr.
PB to 5030'. P/9½ BO plus 21
BWPD, P/19 BO plus 69 BWPD
P/19 BO plus 80 BWPD.
Complete for 17 BOPD plus 75 BWPD. "

10/31 Spud 8-13-51
Oil Well TD 5166
8" @ 615 Layton 3629
DST 3629-38 opn 40 min.
Rec. 130' mud KC 3682
Miss 4372 B. Miss 4715
Viola 4798 Simp. 4806
DST 4803-26 opn 1 hr
Rec. 30' sgcm
DST 4822-34 opn 1 hr
Rec. 70' o & gcm
DST 4830-42 opn 1hr
Rec. 35' gcm DST 4842-50 opn 1 hr
Rec. 15' mud Arb. 5034
DST 5036-83 opn 1 hr
Rec. 602' sw TD 5166
5" @ 5064 32/4808-16 64/4828-44
3000 A S/6½ bo 31 bw S/10 bo 73 bw
9 hr. PB 5030 P/9½ bo 21 bwpd
P/19 bo 69 bwpd Comp. 17 bopd 75 bw

COMPLETED

FORM 275 FOR SALE BY KANSAS BLUE PRINT CO.


County Sumner State Kansas

Sec. 9 (Blk. Twp.) 35 (Sur. Rge.) 3W Map No.

Operator Magnolia

Well No. 4 Farm Hudson

Elev. 1130 Location SW SW NE

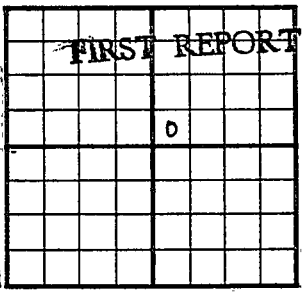

330 Ft. From S Line NE

330 Ft. From W Line Quarter

1st. Report AUG 8 1951

Completion

Remarks 1/2 mile from MCPC block in sec. 8


Spudding Date

Drlg. Data Fall Creek Pool

Location

J. E. TYRA

Drlg. Data

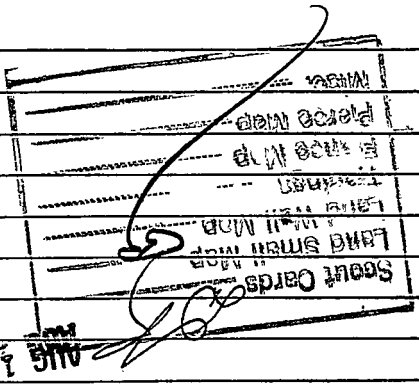
Scout Cards
Land Small Map
Land Wall Map
Transparencies
Plastic Relief Map
Plastic Map
Misc.

FORM 275 FOR SALE BY KANSAS BLUE PRINT CO.


County Sumner State Kansas

Sec. 9 (Blk. Twp.) 35 (Sur. Rge.) 3W Map No.

Operator Magnolia

Well No. 4 Farm Hudson

Elev. 1130 Location SW SW NE

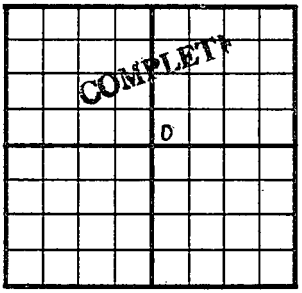

330 Ft. From S Line NE

330 Ft. From W Line Quarter

1st. Report

Completion OCT 31 1951

Remarks Fall Creek Pool

Spudding Date 8-13-51

Drlg. Data Oil well TD 5166

8" @ 615 Layton 3629 DST 3629-38

open 40 min. Rec. 130' mud KC 3682

Miss. 4372 BMiss. 4715 Viola 4798

Simp. 4806 DST 4803-26 open 1 hr.

Rec. 30'sgcm DST 4822-34 open 1 hr.

Rec. 70' o & gcm DST 4830-42 open 1 hr.

Rec. 35' gcm DST 4842-50 open 1 hr.

Rec. 15' mud Arb. 5034 DST 5036-83

open 1 hr. Rec. 602' sw TD 5166

5" @ 5064 32/ 4808-16 64/ 4828-44

3000 A S/ 6½ bo 31 bw S/ 10 bo 73 bw

9 hr. PB 5030 P/ 9½ bo 21 bwpd

P/ 19 bo 69 bwpd Comp. 17 bopd 75 bw

J. E. TYRA

May 14 [95]

Scout Cards
Land Small Map
Land Well Map
Tracings
France Map
Pierce Map
Misc.

Drlg. Data