

Section 9 Township 35 Range 3W

Well No. #4 Peters

Company Texas

NORTH

						0	

WEST

EAST

SOUTH

Sumner

HOT FILE
KANSAS


Sec. 9 Twp. 35 R. 3 W

Well No. # 4 Peters Farm

Texas Company

Contractor

Fall Creek Pool

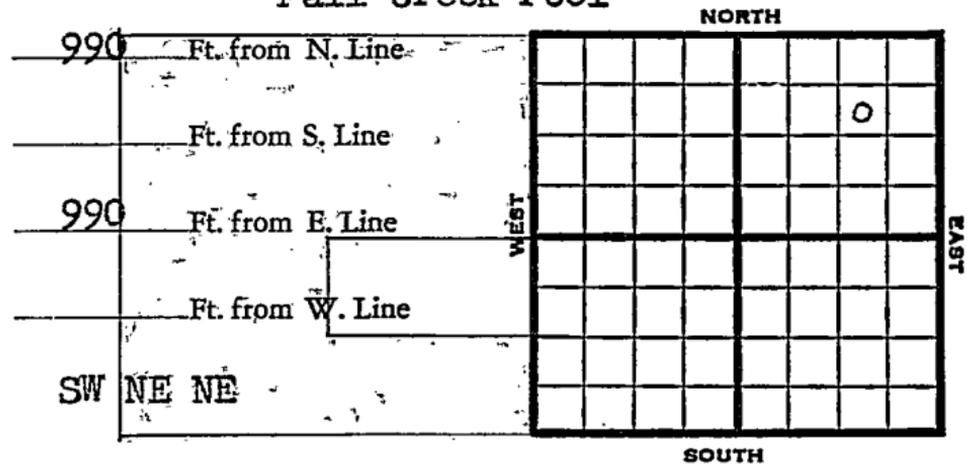

1951 Elev. 1124' **REPORT**

5/9 Cellar & pits
7/19 Spudded 5-18-51
10" at 604'
KC. 3647'
Miss. 4348'
Krider 4696'
Misenor 4744'
Viola 4751'
Simpson 4765'
RTD 4814'
7" at 4813'
CO to 4808'
16/ 4789'-94' hole full oil
35/ 4770'-79'
12/ 4786'89'
24/ 4794'- 4801'
Flowed 71bbls oil 12 hrs.
1500 A. flowed 120 bbls oil 12½ hrs.
on ¼" choke - testing. (L R)
7/26 comp. for indicated capacity of 4736
bopd. Flow test pot. 418 bopd.
no water. Gravity 50 degrees.
GOR 516-1 comp. (L R)

OVER

1951

7/25 Spud 5-18-51
Oil Well TD 4814
10" @ 604'
KC 3647 Miss 4348
Kridler 4696 Misenor 4744
Viola 4751 Simp 4765
TD 4814 7" @ 4813
16/4789-94 HFO 35/4770-79
12/4786-89 24/4794-4801
F/71 bo 12 hr. 1500 A
F/120 bo 12½ hr. F/418 bopd
Comp. BHB 4736 bopd

COMPLETED

Scout Cards	mm
Land Small Map	
Land Wall Map	3
Tracings	
France Map	
Misc.	

MAY 11 1951

Prig. Data

100
100

JUL 27 1971

Scout Cards	
Land Small Map	
Land Wall Map	3
Tracings	
France Map	
Pierce Map	
Misc.	

Prig. Data