


Section 5 Township 3 Range 11W

Well No. #1 Lull

Company J. H. Snowden

NORTH

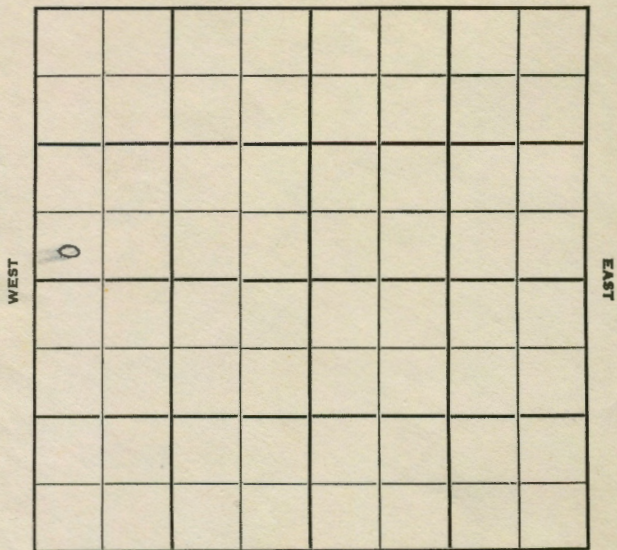

SOUTH

5

Sec. 5 Twp. 3 R. 11 W

Well No. # 1 Lull Farm

J. H. Snowden Company

Deek Contractor

..... Ft. from N. Line


330 Ft. from S. Line

..... Ft. from E. Line

330 Ft. from W. Line

SW NW

NORTH

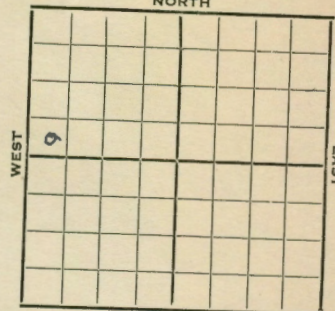

SOUTH

1951 Elev. 1840' REPORT

12/5 Spud 11-30-51
8" @ 213

Drlg. 1832'

12/19 Spud 11-30-51
D&A TD 4176
8" @ 213'

Anhy 1260 Ft. Riley 1655

Top. 2625 KC 2895

B KC 3235 Miss. 3596

Arb. 4150-76

D&A

ABANDONED

