


KANSAS

Phillips

FORM 51 5M 10-41 PETROL

Section 31 Township 3 Range 17-WWell No. #1 W. C. HooverCompany Goode & Floyd

Wildcat

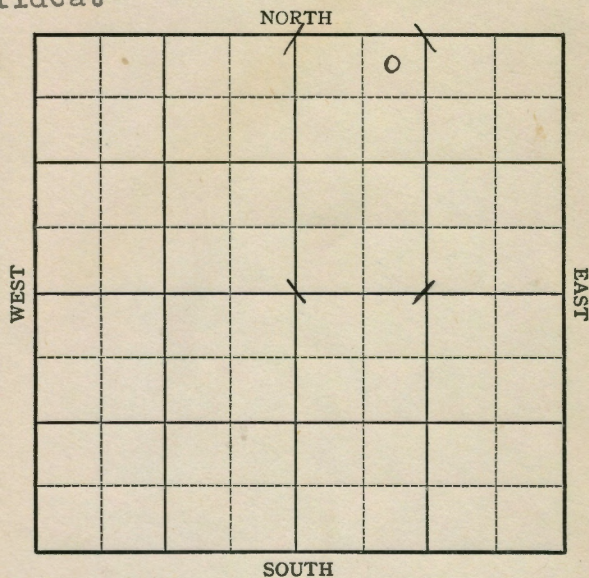

2

Form 252-A
5M 5-42 Petrol

KANSAS

Phillips


Sec. 31 Twp. 3 R. 17-WWell No. #1 W. C. Hoover FarmGoode & Floyd Company

Wildcat

330 Ft. from N. Line

Ft. from S. Line

Ft. from E. Line

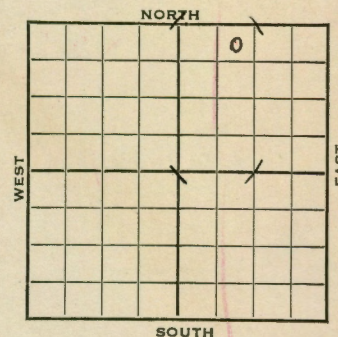990 Ft. from W. Line

NE NW NE

1942

REPORT

12/9

8" - 101'

Drbg. 2700'

Any 1475'

12/16

Lans 3145

Arb. 3694

No shows.

T.D. 3712'

ABANDONED

Phillips

KANSAS

Map No. 132 Sec. 31 Twp. 3 R. 17WWell No. 1 W. C. Hoover

Goode & Floyd

Company

FIRST REPORT

Contractor

NE NW NE

SECTION PLAT

330


Ft. from N. Line

Ft. from S. Line

Ft. from E. Line

990

Ft. from W. Line

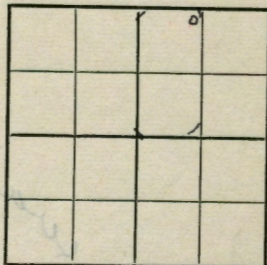

WILDCAT

Location

Rig up

Drilling and Remarks:

8"-101'

Drig. 2700'

Anhy 1475'

RECORD

Cased in. ft.

Sand

Gas

Oil

Total Depth

PRODUCTION

1st 24 hrs. Nat.

1st 24 hrs. after shot

Gas Cu. Ft.

Dry Hole

Abandoned

Date

DEC 9 1942

19

S. J. LEWIS

Scout

Phillips

KANSAS

Map No. 132 Sec. 31 Twp. 3 R. 17WWell No. 1 W. C. Hoover

Goode & Floyd

Company

ABANDONED

Contractor

NE NW NE

SECTION PLAT

330


Ft. from N. Line

Ft. from S. Line

Ft. from E. Line

990

Ft. from W. Line

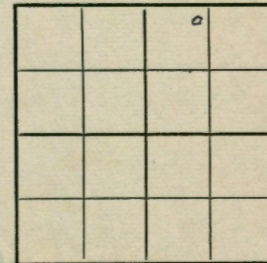

WILDCAT

Location

Rig up

Drilling and Remarks:

Line 8145'

Box 3694

No shows

RECORD

Cased in. ft.

Sand

Gas

Oil

Total Depth

PRODUCTION

1st 24 hrs. Nat.

1st 24 hrs. after shot

Gas Cu. Ft.

Dry Hole

Abandoned

Date

DEC 16 1942

19

S. J. LEWIS

Scout