

KANSAS

FORM 51 5M 10-41 PETROL


Phillips

Section 17 Township 3 Range 18-W

Well No. #1 Buerlein

Company Davis-Child Motor

Wildcat

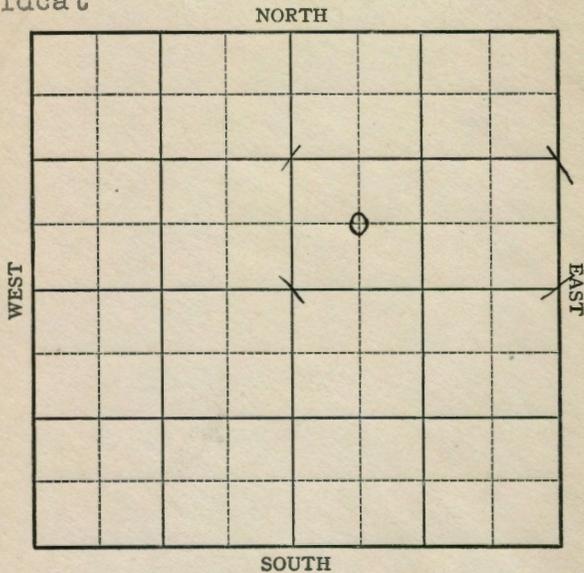

7

Form 252-A  
5M 5-42 Petrol

KANSAS

Phillips

Sec. 17 Twp. 3 R. 18-W

Well No. #1 Buerlein

Davis-Child Motor Company


Wildcat

Ft. from N. Line

660 Ft. from S. Line

Ft. from E. Line

660 Ft. from W. Line

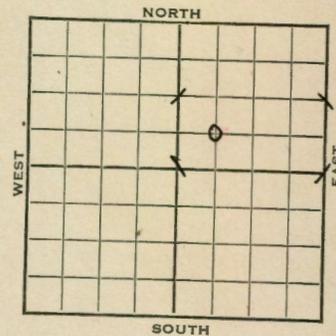

C SW NE

Elev. 1960

1942

REPORT

12/9

Loc.  
Carter Farmout

12/16

Surface hole

12/22

" "

12/29

10" 150' WOC

1943

1/6

Anhy 1530  
Drlg. 3010'

1/13

Topeka 2980  
Lans 3202  
Arb. 3606  
T.D. 3664'  
No shows.

ABANDONED

Map No. 132 Sec. 17 Twp. 3 R. 18W

Well No. 1 Buerlein

Davis-Child Motor Company

**FIRST REPORT**

Contractor

C SW NE


SECTION PLAT

\_\_\_\_\_ Ft. from N. Line

660 Ft. from S. Line

\_\_\_\_\_ Ft. from E. Line

660 Ft. from W. Line

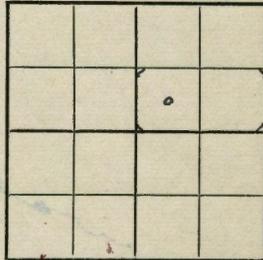

WILDCAT

Location XX

Rig up \_\_\_\_\_

Drilling and Remarks:

Carter Farmout

RECORD

Cased \_\_\_\_\_ in., \_\_\_\_\_ ft.

Sand \_\_\_\_\_

Gas \_\_\_\_\_

Oil \_\_\_\_\_

Total Depth \_\_\_\_\_

PRODUCTION

1st 24 hrs. Nat. \_\_\_\_\_

1st 24 hrs. after shot \_\_\_\_\_

Gas \_\_\_\_\_ Cu. Ft.

Dry Hole \_\_\_\_\_

Abandoned \_\_\_\_\_

Date

DEC 9 1942 19

S. J. LEWIS Scout

Map No. 132 Sec. 17 Twp. 3 R. 18W

Well No. 1 Burelein

Davis-Child Motor Company

**ABANDONED**

Contractor

C SW NE


SECTION PLAT

\_\_\_\_\_ Ft. from N. Line

660 Ft. from S. Line

\_\_\_\_\_ Ft. from E. Line

660 Ft. from W. Line

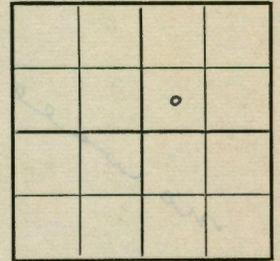

WILDCAT

Location \_\_\_\_\_

Rig up \_\_\_\_\_

Drilling and Remarks:

Topo ka 2980

Lans 8202

Box 8606

Noe hows

RECORD

Cased \_\_\_\_\_ in., \_\_\_\_\_ ft.

Sand \_\_\_\_\_

Gas \_\_\_\_\_

Oil \_\_\_\_\_

Total Depth 3664

PRODUCTION

1st 24 hrs. Nat. \_\_\_\_\_

1st 24 hrs. after shot \_\_\_\_\_

Gas \_\_\_\_\_ Cu. Ft.

Dry Hole \_\_\_\_\_

Abandoned \_\_\_\_\_

Date

JAN 13 1943 19

S. J. LEWIS Scout