


Section 14 Township 3 Range 19W

Well No. #1 Hempler

Company Phillips

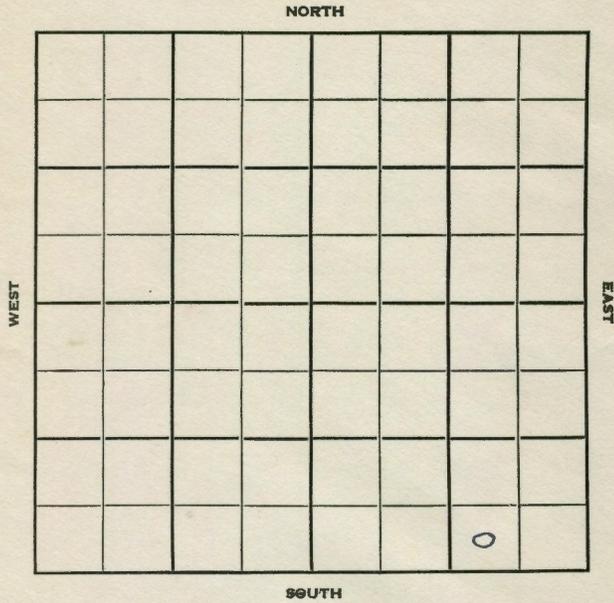

16

Sec. 14 Twp. 3 R. 19W

Well No. #1 Hempler Farm _____

Phillips Company _____


Contractor _____

_____ Ft. from N. Line

330' Ft. from S. Line

990' Ft. from E. Line

_____ Ft. from W. Line

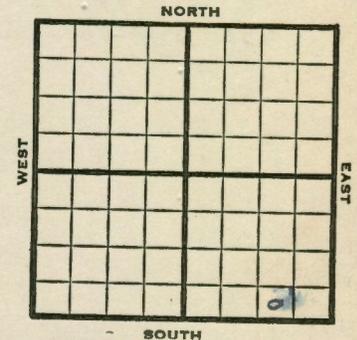

SW SE SE

1952	Elev. 1963'	REPORT
2/27	MIR	
3/5	8" @ 259'	Drlg. 1830'
3/12	Howard 2846'	Topeka 2874'
	Heeb 3042'	Tor 3064'
	Lans. 3084'	TD 3340'
	5" @ 3329'	WOC
3/19	CO to 3314	36/3274-83 500 A
	5 1/2 Bot 1/4 BW	5 hrs.
	28/3250-57	28/3233-40 32/3208-16
	500 A	S/8 BO & 9 1/4 BW 10 hrs. to A
3/25	2500 A	S/ 18 BO & 4 1/2 BW 7 1/2 hr.
	Set plug 3175	20/3160-65 500 A
	S/ 17 1/4 BO & 2 BW	6 hrs. set plug
	3150	28/ 3135-42 32/ 3116-24
	500 A	S/ 45 BO & 5 BW 8 hrs.
	Set plug 3100	28/ 3083-90 500 A
	S/ 18 BO & 2 BAW	3 hrs. 1800 A
	S/ 37 BO & 3 BW	5 hrs. DO to 3307
	S/ 48 BO & 2 BW	5 hrs.
4/1	POP	
4/9	P/ 70 BO	14 hrs.
4/23	Spud 3-1-52	
	Oil Well TD 3340	8" @ 259'
	Howard 2846	To. 2874 Heeb. 3042
	Tor. 3064	Lans. 3084

OVER

1952

4/23 TD 3340' 5" @ 3329 CO to 3314'
36/ 3274-83 500 A S/ 1/2 BO
 $\frac{1}{4}$ BW 5 hr. 28/ 3250-57
28/ 3233-40 32/ 3208-16 500 A
S/ 9 BO $9\frac{1}{4}$ BW 10 hr. 2500 A
S/ 18 BO $4\frac{1}{2}$ BW $7\frac{1}{2}$ hr. SP 3175
20/ 3160-65 500 A S/ $17\frac{1}{4}$ BO
2 BW 6 hr. SP 3150 28/ 3135-42
32/ 3116-24 500 A S/ 45 BO 5 BW
8 hr. SP 3100 28/ 3083-90
500 A S/ 18 BO 2 BW 3 hr. 1500 A
S/ 32 BO 3 BW 5 hr. DO to 3307
S/ 48 BO 3 BW 5 hr. P/ 70 BO 14 hr.
Comp. 111 bopd 10% wtr.

COMPLETED

