

NORTH

WEST

EAST

SOUTH

8

SE SE NE

NORTH

WEST

EAST

SOUTH

COMPLETED

County Phillips State Kansas
 Sec. 14 (Blk. 3 (Sur. 19W Map No.
 (Twp.) (Rge.)
 Operator Imperial Oil
 Well No. 1 Farm Vogel
 Elev. 2010 Location SE SE NE

330 Ft. From S Line NE
 330 Ft. From E Line Quarter

1st. Report

Completion SEP 19 1951

Remarks OWDD

Spudding Date

Drig. Data Oil well TD 3186

KC 3128 5 $\frac{1}{2}$ " @ 3145 OTD 3150 DD 3182
2000 A FU 2000' fluid 8 hr. DD 3186
no inc. Comp. 8 bopd 14 bw

J. E. TYRA

County Phillips State Kansas
 Sec. 14 (Blk. 3 (Sur. 19W Map No.
 (Twp.) (Rge.)
 Operator Imperial Oil
 Well No. 1 Farm Vogel
 Elev. 2010 Location SE SE NE

330 Ft. From S Line NE

330 Ft. From E Line Quarter

1st. Report AUG 15 1951

Completion

Remarks OWDD

Spudding Date

Drig. Data

KC 3128 5 $\frac{1}{2}$ " @ 3145 OTD 3150
DD 3182 2000 A


J. E. TYRA

County Phillips State Kansas
 Sec. 14 (Blk. 3 (Sur. 19W Map No. 19W)
 (Twp.) (Rge.)

Operator Imperial Oil

Well No. 1 Farm Vogel

Elev. 2010 Location SE SE NE

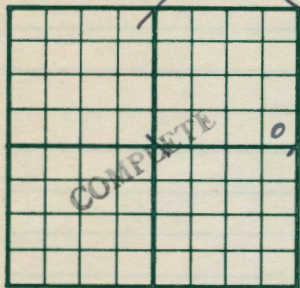

330 Ft. From S Line NE

330 Ft. From E Line Quarter

1st. Report

Completion DEC 27 1950

Remarks Wildcat

K & E Drlg. - Contr.

Spudding Date 11-21-50

Drlg. Data Oil well TD 3150

8" @ 168 Anhy 1500-30 Top. 2904

Heeb. 3104 Toronto 3128 Lans. 3147

DST 3146-50 open 20 min. Rec. 800'

clear oil 5" @ 3145 TD 3150

S/ 20 boph FU 2800' oil 10 hr. 500 A

S/ 15 boph Comp. 503 bopd


J. E. TYRA

County Phillips State Kansas
 Sec. 14 (Blk. 3 (Sur. 19W Map No. 19W)
 (Twp.) (Rge.)

Operator Imperial Oil

Well No. 1 Farm Vogel

Elev. Location SE SE NE

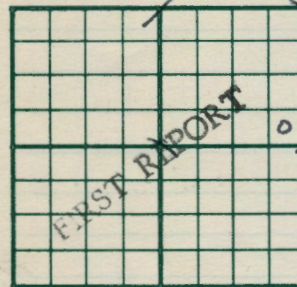

330 Ft. From S Line NE

330 Ft. From E Line Quarter

1st. Report NOV 22 1950

Completion

Remarks Phillips DHM

K & E Drlg. - Contr.

Spudding Date 11-21-50

Drlg. Data Wildcat

8" @ 168 WOC

J. E. TYRA