


Section 14 Township 3 Range 19 W

Well No. #2 Hempler

Company Phillips Petroleum

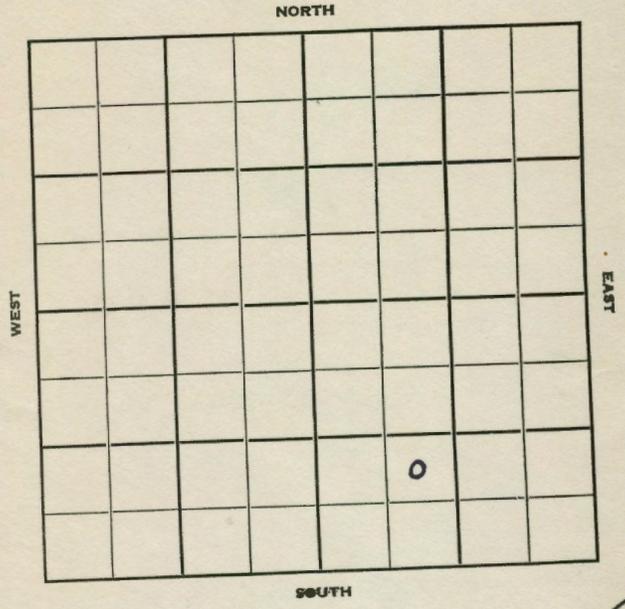

15

Section 14 Twp. 3 R. 19W

Well No. #2 Hempler Farm

Company Phillips Pet.

Contractor Anschutz Drlg.


_____ Ft. from N. Line

990 Ft. from S. Line

_____ Ft. from E. Line

990 Ft. from W. Line

NE SW SE

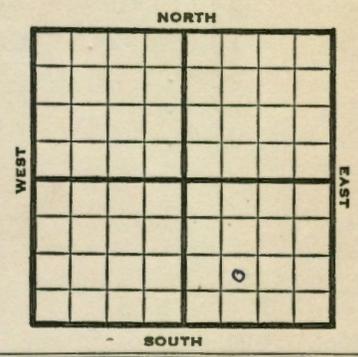

1952	Elev. 1964'	REPORT
3/19		Spud 3-15-52 8" @ 255' Drlg. 1885'
3/25		Howard 2151 Topeka 2181 Heeb. 3050 Tor. 3072 Lans. 3090 B KC 3318 TD 3347 5" @ 3346
4/1		CO to 3322 28/311-18 S/ 5 boph for 13 hrs. set plug 3305 24/ 3266-72 32/ 3246-54 36/ 3221-30 500 A S/ 1 BO & 17 BW 10 hrs. set plug 3214 28/3188-95 64/ 3166-82 B/ 1 1/2 gal. oil & 3/4 gal wtr. 500 A
4/9		S/ 13 BO & 10 BW 11 hrs. 28/ 3146-53 36/ 3126-35 S/ 3 1/2 BO & 1 BW 2 hrs. 1000 A S/ 53 BO & 8 1/2 BW 5 hrs. DO to 3208 S/ 62 1/2 BO & 4 BW 4 hrs. POP
4/23		NR
4/30		Spud 3-15-52 Oil well TD 3347' 8" @ 255' Howard 2151' Top 2181' Heeb 3050' Tor. 3072' Lans. 3090' B KC 3318' TD 3347' 5" @ 3346' CO to 3322'

OVER

1952
4/30

(Information continued)

28/3311-18 S/5 BWPB 13 hr.

SP 3305' 24/3266-72 32/3246-54

36/3221-30 500 A S/1 BO 17 BW

10 hr. SP 3214 28/3188-95 64/3166

-82. B/1/2 GO 3/4 GW 500 A

S/13 BO 10 BW 11 hr.

28/3146-53 36/3126-35 S/3 1/2 BO

1 BW 2 hr. 1000 A S/53 BO 8 1/2 BW

5 hr. DO to 3208 S/62 1/2 BO 4 BW

4 hr.

Comp. 194 BOPD 152 BW

COMPLETED

