


Section 14 Township 3 Range 19 W

Well No. # 3 Vogel

Company Phillips Pet.

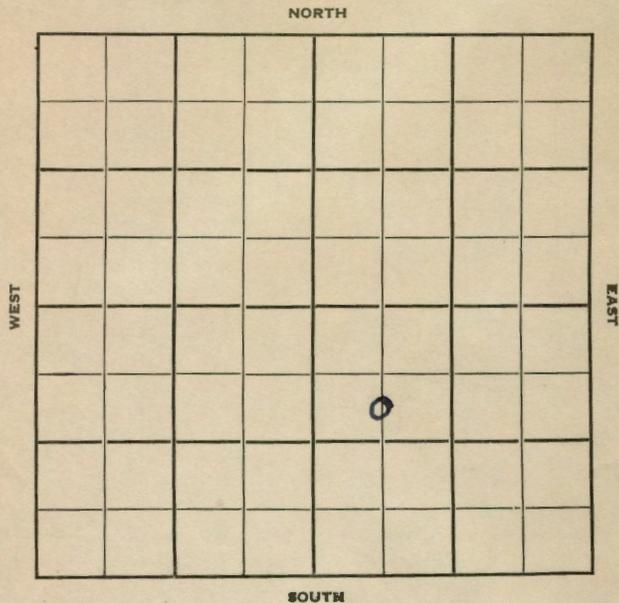

10


Sec. 14 Twp. 3 R. 19 W

Well No. # 3 Vogel

Company Phillips Pet.

Contractor _____

990 Ft. from N. Line
 _____ Ft. from S. Line
 _____ Ft. from E. Line
 660 Ft. from W. Line

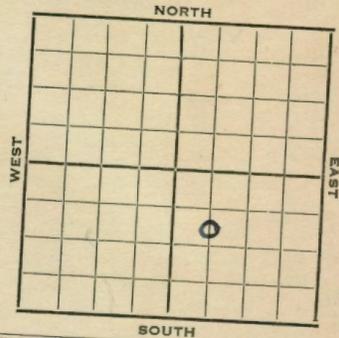

C S L NW SE

1952 **Elev. 1964'** REPORT

- 4/23 Spud 4-20-52
8" @ 284' WOC
- 4/30 **Howard 2857 Topeka 2884**
Heeb. 3056 Tor 3084
Lans. 3099 BKC 3324
TD 3338 5" @
- 5/7 5" @ 3336'
- 5/14 CO 3316' 40/3250-60 32/3224-32
500 A S/1 1/2 BOPH 1000 A S/load
- 5/21 S/10 1/2 BO & 8 BW 3 hrs.
24/3151-57 S1 1/2 BO & 27 1/2 BW 6 hrs.
Sq off PB 3149 32/3131-39
500 A S/74 BW Sq off DO 3118
To perf.
- 5/28 36/3100-3109 500 A S/19 BW plus
scum oil 4 hrs, Set plug 3095'
28/3081-88 S/22 BW 8 hrs. Sq. off
- 6/11 NR
- 6/18 NR
- 6/25 Spud 4-20-52
D&A TD 3338' 8" @ 284'
Howard 2857 Top. 2884
Heeb. 3056 Tor. 3084
Lans. 3099 B KC 3324
TD 3338' 5" @ 3224-32 500 A
S/ 1 1/2 boph 1000 A S/ load
S/ 10 1/2 bo 8 bw 3 hr.

OVER

1952

6/25 24/ 3151-57 S/ 1½ bo 27½ bw
6 hr. FB 3149 32/ 3131-39
500 A S/ 7½ bw DO 3118
36/ 3100-3109 500 A S/ 19 bw
scum oil 4 hr. SP 3095
28/ 3081-88 S/ 22 bw 8 hr.
DO to 3144 16/ 3131-39 SP 3116
500 A S/ 3 bwph D&A

ABANDONED

