


Section 14 Township 3 Range 19-W

Well No. #4 Vogel

Company Imperial Petroleum

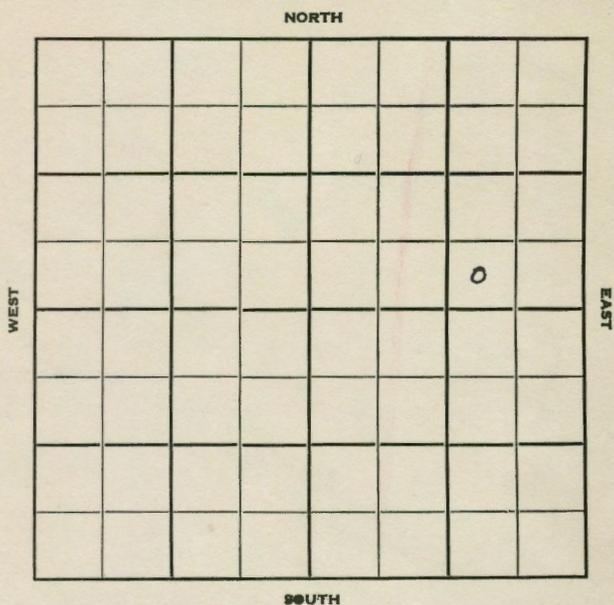

8

Sec. 14 Twp. 3 R. 19-W

Well No. #4 Vogel

Farm _____

Company Imperial Petroleum

Contractor K & E Drlg.

Stuttgart


_____ Ft. from N. Line

330 Ft. from S. Line

990 Ft. from E. Line

_____ Ft. from W. Line

SW SE NE

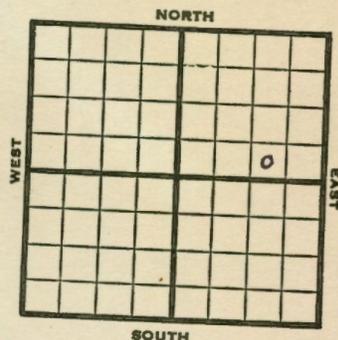

1951 **Elev. 1992'** REPORT

1/10
2/28

MIM
 Spud 1-10-51
 Oil Well TD 3247
 8" @ 175'
 Anhy 1470-1515 Heeb. 3088
 Toronto 3116' Lans. 3132
 DST 3162-82 opn 1 hr
 Rec. 60' socm
 TI 3247
 5" @ 3227 SP 3212
 6/3170-71 S/3/4 bwph SP 3150
 24/3138-42 B/20 goph 900 A
 S/6 bo 12 hr Comp. 51 bopd 40% wtr.

COMPLETED

