


KANSAS

Section 1 Township 3 Range 19W

Well No. #1 Byerlein

Company Octave LeBlanc et al

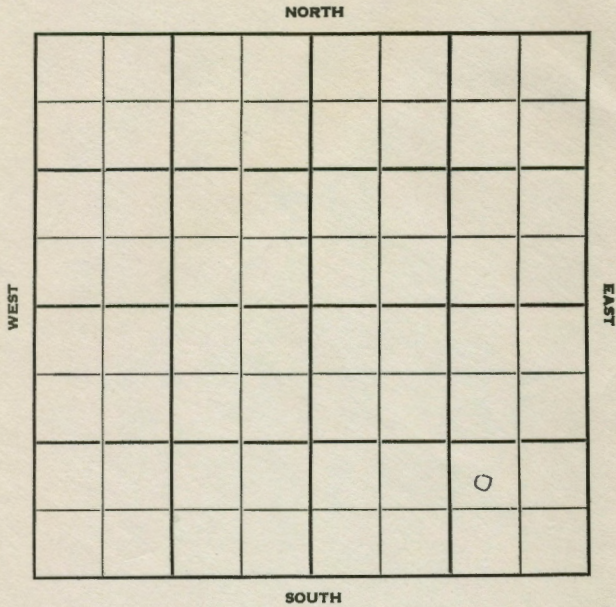

16

Phillips

KANSAS

Sec. 1 Twp. 3 R. 19W

Well No. #1 Byerlein

Octave LeBlanc et al

Stearns Drlg. - Contr.

Wildcat

Ft. from N. Line

990'


Ft. from S. Line

990'

Ft. from E. Line

Ft. from W. Line

NW SE SE

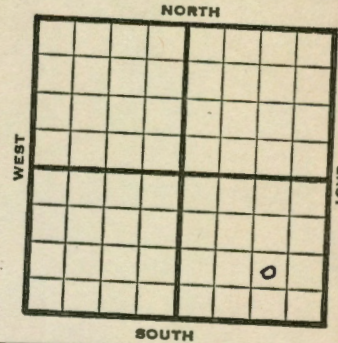

1951

Elev. 2047' REPORT

8/29

Spud 8-18-51

8" @ 203

Anhy 1665

TD 3610'

9/5

Spud 8-18-51

D&A TD 3610

8" @ 203

Anhy 1665

KC 3127

TD 3610

D&A

ABANDONED

