

KANSAS


FORM 51 5M 10-41 PETROL

Phillips

Section 1 Township 3 Range 19-WWell No. #2 F. H. EltisteCompany Carter

Dayton Pool

NORTH

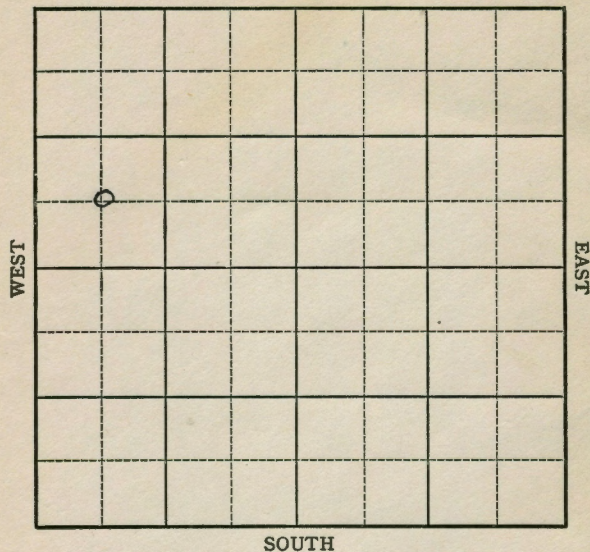Form 252-A
5M 5-42 Petrol

KANSAS

Phillips

Sec. 1 Twp. 3 R. 19-WWell No. #2 F. H. Eltiste Farm

Carter

Company

(Dayton Pool)


Ft. from N. Line

660 Ft. from S. Line

Ft. from E. Line

660 Ft. from W. Line

Elev. 2061

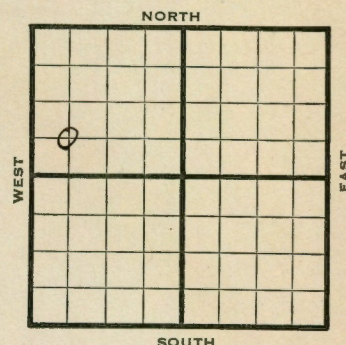

1942

REPORT

8/5 8"-249' Waiting on cement

8/12 Lans 3127
TD 3325 5"@ 3324 Rust.

8/19 Ripped csg. 3194-3201, 3174-81
3101-22 - testing.

8/27 5000 acid swab 16 oil per hr
4 hrs.

9/2 **Lans. 3127** 4" - 3324'
Ripped csg. 5000 acid
Pump 291 Pot.
T.D. 3325
Gravity 38.2

COMPLETED

Phillips

KANSAS

Map No. 133 Sec. 1 Twp. 3 R. 19WWell No. 2 F. H. Eltiste

Carter

Company

COMPLETED

Contractor

C SW NW

SECTION PLAT

Ft. from N. Line

660 Ft. from S. Line

Ft. from E. Line

660 Ft. from W. Line

o			

DAYTON POOL

Location

Rig up

Drilling and Remarks:

*Lane 3/27**4" @ 3324**Ripped csg.**5000 cu. ft.**Pump 29/10/28**382 cu*

RECORD

Cased in, ft.

Sand

Gas

Oil

Total Depth 3325

PRODUCTION

1st 24 hrs. Nat.

1st 24 hrs. after shot

Gas Cu. Ft.

Dry Hole

Abandoned

Date

SEP 2 1942 19

S. J. LEWIS Scout

Phillips KANSAS

Map No. 133 Sec. 1 Twp. 3 R. 19WWell No. 2 F. H. Eltiste

Carter

Company

FIRST REPORT

Contractor

C SW NW

SECTION PLAT

Ft. from N. Line

660 Ft. from S. Line

Ft. from E. Line

660 Ft. from W. Line

o			

DAYTON POOL

Location

Rig up

Drilling and Remarks:

8"-249'Waiting on
cement

RECORD

Cased in, ft.

Sand

Gas

Oil

Total Depth

PRODUCTION

1st 24 hrs. Nat.

1st 24 hrs. after shot

Gas Cu. Ft.

Dry Hole

Abandoned

Date

AUG 5 1942 19

S. J. LEWIS Scout