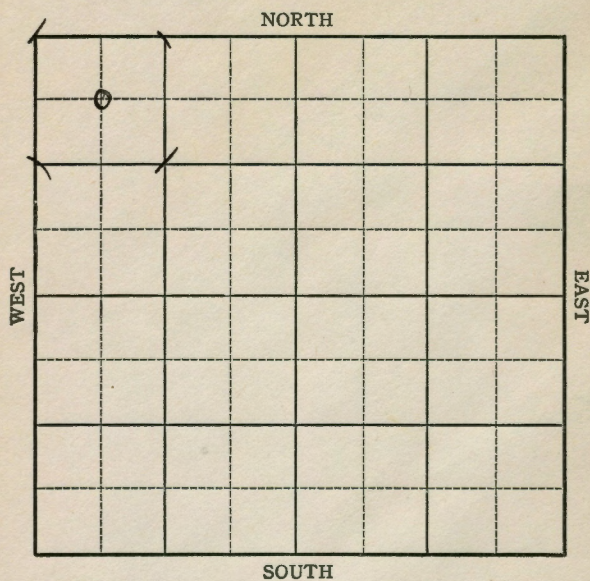


KANSAS

Phillips

FORM 51 5M 10-41 PETROL

Section 1 Township 3 Range 19-WWell No. #2 GroteCompany Carter

4

Form 252-A
5M 5-42 Petrol

KANSAS

Phillips

Sec. 1 Twp. 3 R. 19-WWell No. #2 Grote Farm _____

Carter Company

(Dayton)


660 Ft. from N. Line

Ft. from S. Line

Ft. from E. Line

660 Ft. from W. Line

Elev. 2092

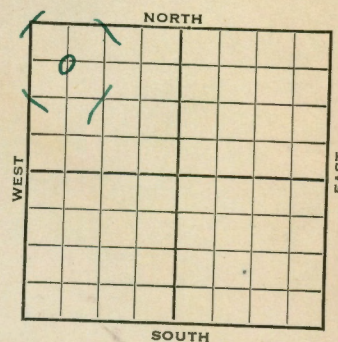

1942	REPORT
7/15	Location
7/22	8" - 293' Drlg. 15458
7/29	Drlg. 3242'
8/5	Anhy 1566 Topeka 2937
	Lans. 3165 S.O. 3165-3556
	5" - 3355 RUST
8/12	" " "
8/19	6000 acid swab 13 oil per hour - 4 hour
8/27	Lans. 3165 5" - 3355
	Perf. Lans
	6000 acid
	Pump 73 oil & 8 hrs
	Pump 219 Pot. & 24 water
	T.D. 3356
	Gravity 35.8

COMPLETED

Phillips

KANSAS

Map No. 133 Sec. 1 Twp. 3 R. 19WWell No. 2 Grote

Carter

Company

COMPLETED

Contractor

C NW NW

SECTION PLAT

660

Ft. from N. Line

Ft. from S. Line

Ft. from E. Line

660

Ft. from W. Line

DAYTON POOL

Location

Rig up

Drilling and Remarks:

*Lane 3165**5" 3355**Prof Lane**6000 acid**Pump 3300 lbs**11 219 Pst 124 1/2**35 E Gr*

Date

AUG 27 1942 19

S. J. LEWIS

Scout

RECORD

Cased in. ft.

Sand

Gas

Oil

Total Depth *3356*

PRODUCTION

1st 24 hrs. Nat.

1st 24 hrs. after shot

Gas Cu. Ft.

Dry Hole

Abandoned

Phillips

KANSAS

Map No. 133 Sec. 1 Twp. 3 R. 19WWell No. 2 Grote

Carter

Company

FIRST REPORT

Contractor

C NW NW

SECTION PLAT

660

Ft. from N. Line

Ft. from S. Line

Ft. from E. Line

660

Ft. from W. Line

DAYTON POOL

Location XX

Rig up

Drilling and Remarks:

RECORD

Cased in. ft.

Sand

Gas

Oil

Total Depth

PRODUCTION

1st 24 hrs. Nat.

1st 24 hrs. after shot

Gas Cu. Ft.

Dry Hole

Abandoned

Date

JUL 15 1942 19

S. J. LEWIS

Scout