

KANSAS


FORM 51 5M 10-41 PETROL

Phillips

Section 1 Township 3 Range 19-WWell No. #2 KlotzCompany Allan et al.

Dayton Pool

NORTH

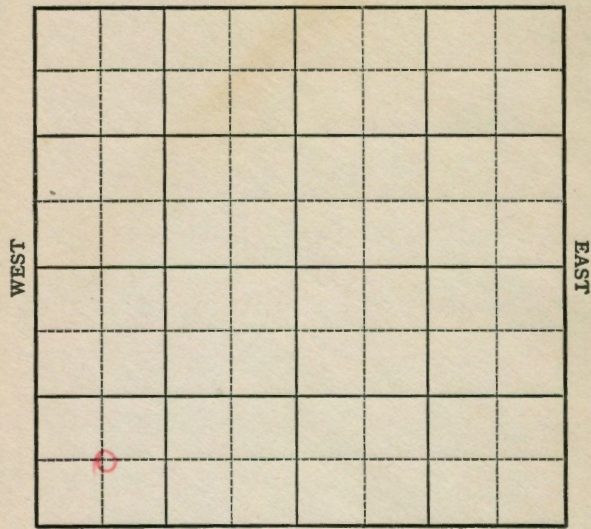

SOUTH

13

Form 252-A  
5M 5-42 Petrol

KANSAS

Phillips

Sec. 1 Twp. 3 R. 19-WWell No. #2 Klotz Farm \_\_\_\_\_

Allan et al Company \_\_\_\_\_


(Dayton Pool)

Ft. from N. Line

660 Ft. from S. Line

Ft. from E. Line

660 Ft. from W. Line

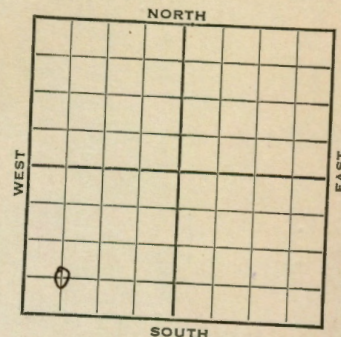Elev. 2007

1942

REPORT

| 1942  | Location                 |
|-------|--------------------------|
| 9/16  | "                        |
| 9/23  | "                        |
| 9/30  | "                        |
| 10/7  | "                        |
| 10/14 | "                        |
| 10/21 | 10" @ 53'                |
|       | Drlg 2035                |
| 10/29 | <del>Lans.</del> 3101    |
|       | TD 3170                  |
|       | 5" @ 3170 Rust           |
| 11/4  | TD 3219                  |
|       | 3000 acid                |
|       | testing SD               |
| 11/11 | Swab 8 bbls. oil per hr. |
|       | 3000 Acid                |
| 11/18 | Testing                  |
| 11/24 | "                        |
| 12/2  | Temp pob 15              |
| 12/9  | " "                      |
| 12/16 | " "                      |
| 12/22 | " "                      |
| 12.29 | " "                      |

OVER

1943  
1/6 Temp. Pot 15  
1/13 " "  
1/20 " "  
1/27 " "  
2/3 " "  
2/10 " "  
2/17 **Lans 3101**  
5" @ 3170'  
T.D. 3219'  
6000 gal acid  
Pump 306 pot.  
Gravity 35.8

**COMPLETED**

Phillips

KANSAS

Map No. 133 Sec. 1 Twp. 3 R. 19WWell No. 2 Klotz

Allan et al.

Company

COMPLETED

Contractor

C SW SW

## SECTION PLAT

Ft. from N. Line

660 Ft. from S. Line

Ft. from E. Line

660 Ft. from W. Line

|  |  |  |  |
|--|--|--|--|
|  |  |  |  |
|  |  |  |  |
|  |  |  |  |
|  |  |  |  |

DAYTON POOL

Location

Rig up

Drilling and Remarks:

Lane 3101

5" C 3170

6000 acid

Pump 306 Pst.

35 E 4

## RECORD

Cased in, ft.

Sand

Gas

Oil

Total Depth 3219

## PRODUCTION

1st 24 hrs. Nat.

1st 24 hrs. after shot

Gas Cu. Ft.

Dry Hole

Abandoned

Date

FEB 17 1943 19

S. J. LEWIS

Scout

Phillips

KANSAS

Map No. 133 Sec. 1 Twp. 3 R. 19WWell No. 2 Klotz

Allan et al.

Company

FIRST REPORT

Contractor

C SW SW

## SECTION PLAT

Ft. from N. Line

660 Ft. from S. Line

Ft. from E. Line

660 Ft. from W. Line

|  |  |  |  |
|--|--|--|--|
|  |  |  |  |
|  |  |  |  |
|  |  |  |  |
|  |  |  |  |

DAYTON POOL

Location XXX

Rig up

Drilling and Remarks:

## RECORD

Cased in, ft.

Sand

Gas

Oil

Total Depth

## PRODUCTION

1st 24 hrs. Nat.

1st 24 hrs. after shot

Gas Cu. Ft.

Dry Hole

Abandoned

Date

SEP 16 1942 19

S. J. LEWIS

Scout