


Section 2 Township 3 Range 19-W
Well No. #1 Eltiste
Company Tom Allan et al

Dayton Pool

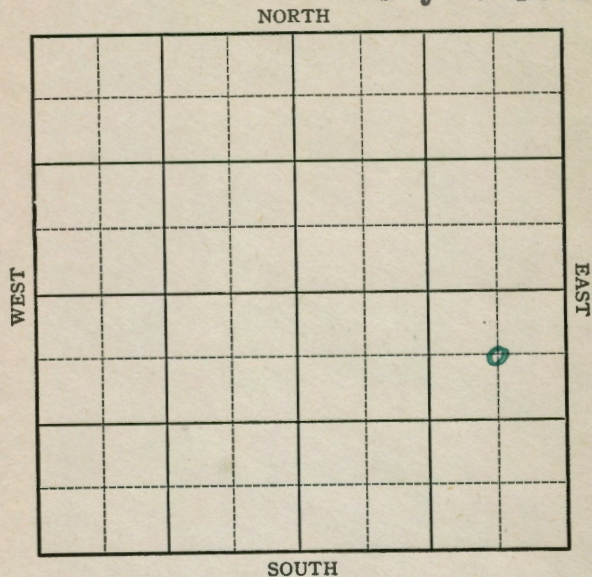

9

Sec. 2 Twp. 3 R. 19-W
Well No. #1 Eltiste Farm
Tom Allan et al Company

(Dayton)


660 Ft. from N. Line

_Ft. from S. Line

660 _____ Ft. from E. Line

_Ft. from W. Line

Elev. 2052

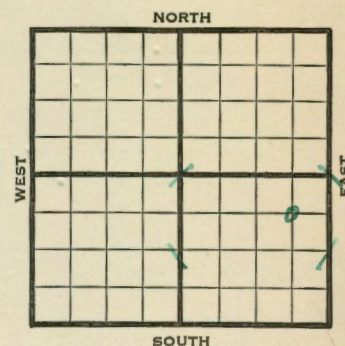

1942	REPORT
6/17	Rotary.
6/24	8" - 69' Anhy. 1515'
	Drlg. 2420'
7/1	T.D. 3316' 5" - 3316' RUST.
7/8	" " "
7/15	T.D. 3345' P.B. to 3313' To rip csg.
7/22	" " "
7/29	" " "
8/5	" " "
8/12	" " "
8/19	" " "
8/27	" " "
9/2	" " "
9/9	" " "
9/16	" " "
9/23	" " "
9/30	SD orders.
	OVER

1942
10/7

Lans. 3130 5" - 3316
Perf. csg. 11750 acid
TD 3345
Pump 422 Pot.
Gravity 35.

COMPLETED

Phillips

Map No. 133 Sec. 2 Twp. 3 R. 19WWell No. 1 Eltiste

Tom Allen et al.

Company

COMPLETED

Contractor

C NE SE


SECTION PLAT

660 Ft. from N. Line

Ft. from S. Line

660 Ft. from E. Line

Ft. from W. Line

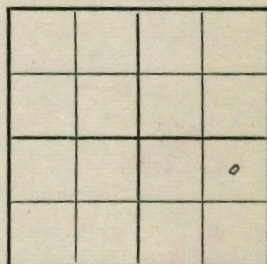

DAYTON POOL

Location

Rig up

Drilling and Remarks:

*Ham 8130**5" C 3316**Prof. C 27**11250 Seal**Pump 422 P.D.**35-2 Gr.*

RECORD

Cased in, ft.

Sand

Gas

Oil

Total Depth *3345*

PRODUCTION

1st 24 hrs. Nat.

1st 24 hrs. after shot

Gas Cu. Ft.

Dry Hole

Abandoned

Date

OCT 7 1942 19

S. J. LEWIS Scout

Phillips

Map No. 133 Sec. 2 Twp. 3 R. 19WWell No. 1 Eltiste

Tom Allan et al.

Company

FIRST REPORT

Contractor

C NE SE


SECTION PLAT

660 Ft. from N. Line

Ft. from S. Line

660 Ft. from E. Line

Ft. from W. Line

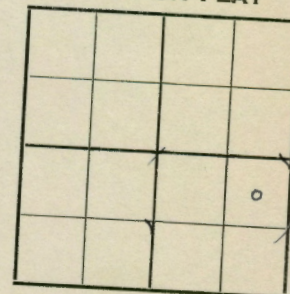

DAYTON POOL

Location

Rig up

Drilling and Remarks:

Rotary

RECORD

Cased in, ft.

Sand

Gas

Oil

Total Depth

PRODUCTION

1st 24 hrs. Nat.

1st 24 hrs. after shot

Gas Cu. Ft.

Dry Hole

Abandoned

Date

JUN 17 1942 19

S. J. LEWIS

Scout