


KANSAS

FORM 51 5M 4-41 PETROL

Phillips

Section 2 Township 3 Range 19-WWell No. #1 F. H. EltisteCompany Carter

NORTH Dayton Pool

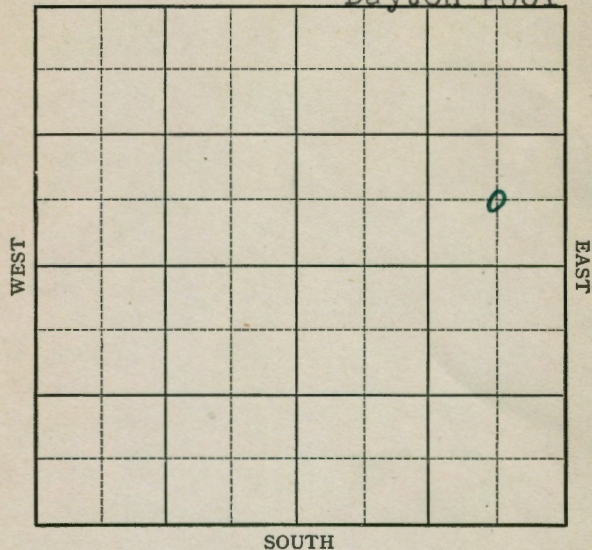

8

Form 252-A
5M 5-42 Petrol

KANSAS


Phillips

Sec. 2 Twp. 3 R. 19-WWell No. #1 F. H. Eltiste FarmCarter Company

(Dayton)

 Ft. from N. Line660 Ft. from S. Line660 Ft. from E. Line Ft. from W. Line

Elev. 2042

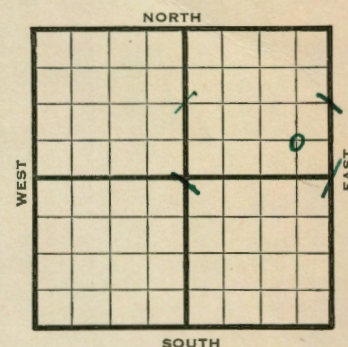

1942

REPORT

6/24

8" - 277' WOC.

7/1

Anhy. 1516' Topeka 2892'
Lans. 3120' Drlg. 3141'

7/8

T.D. 3310' S.O. 5" - 3308' RUST.

7/15

" " "

7/22

Rip csg. 3246-51, 3264-76, 3289-3300'
2000 acid. Water. P.B. to 3236' WOC.

7/29

PB 3230 Rip Csg. 3192-98
3172-80, 3140-44, 3123-30
3500 acid swb 30 oil P.H.

8/5

Lans. 3120'
5" - 3308'
Perf. Lansing
7000 acid
T.D. 3312'
Pump 349 Pot.
Gravity 35.

COMPLETED

Phillips

KANSAS

Map No. 133 Sec. 2 Twp. 3 R. 19WWell No. 1 F. H. Eltiste

Carter

Company

COMPLETED

Contractor

C S E N E

SECTION PLAT

Ft. from N. Line

660 Ft. from S. Line660 Ft. from E. Line

Ft. from W. Line

			o

DAYTON POOL

Location

Rig up

Drilling and Remarks:

*Leans 3/20**5" 3308**Prof. Leaning**7000 acid**Pump 349 B & T.**3524*

RECORD

Cased in, ft.

Sand

Gas

Oil

Total Depth *3312*

PRODUCTION

1st 24 hrs. Nat.

1st 24 hrs. after shot

Gas Cu. Ft.

Dry Hole

Abandoned

Date

AUG 5 1942

19

S. J. LEWIS

Scout

Phillips

KANSAS

Map No. 133 Sec. 2 Twp. 3 R. 19WWell No. 1 F. H. Eltiste

Carter

Company

FIRST REPORT

Contractor

C S E N E

SECTION PLAT

Ft. from N. Line

660 Ft. from S. Line660 Ft. from E. Line

Ft. from W. Line

			o

DAYTON POOL

Location

Rig up

Drilling and Remarks:

8" - 277'

Waiting on

cement

RECORD

Cased in, ft.

Sand

Gas

Oil

Total Depth

PRODUCTION

1st 24 hrs. Nat.

1st 24 hrs. after shot

Gas Cu. Ft.

Dry Hole

Abandoned

Date

JUN 24 1942

19

S. J. LEWIS

Scout