

KANSAS


Phillips

FORM 51 5M 4-41 PETROL

Section 2 Township 3 Range 19-W
 Well No. #1 Grote
 Company Carter

Dayton Pool

NORTH

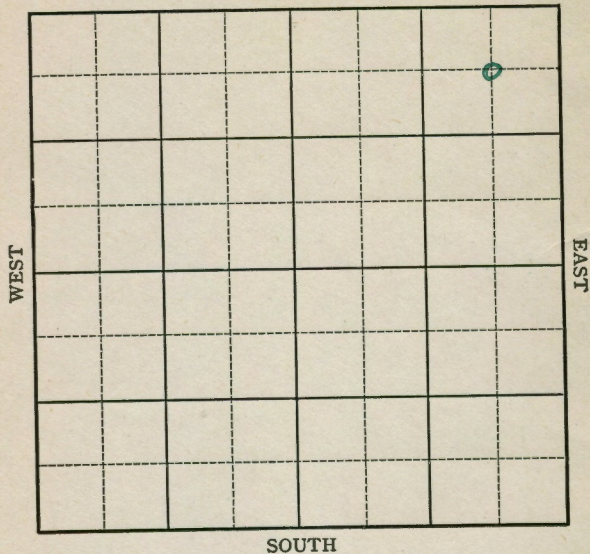

SOUTH

FORM 252 A
5M 10-41 PETROL

KANSAS


Phillips

Sec. 2 Twp. 3 R. 19-W
 Well No. #1 Grote Farm
Carter Company

(Dayton)

660 Ft. from N. Line
 _____ Ft. from S. Line
660 Ft. from E. Line
 _____ Ft. from W. Line

Elw. 2032

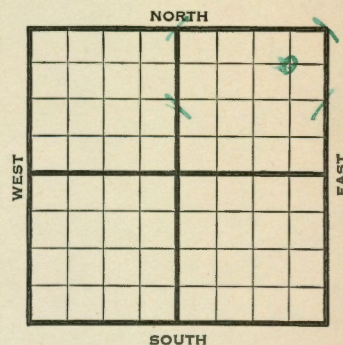

1942	REPORT
6/17	Location
6/24	"
7/1	"
7/8	Surface hole.
7/15	8" - 268' Drlg. 2902'
7/22	Lans. 3114' S.O. 3114-16' T.D. 3304'
	5" - 3300' RUST.
7/29	2500 acid - no shows
	Rip csg. 3279-90, 3250-66
	500 acid swab 3 oil P.H.
8/5	PB 3175
	Rip csg 3114-69 3500 acid
	Swab 1 oil per hr.
8/12	4000 acid swab 2 oil per hr 11 hrs
8/19	" " " " "
8/27	Lans. 3114 5" - 3300
	Perf. Lans. 10250 acid
	Pump 66 Pot.
	T.D. 3304
	Gravity 35.8
	COMPLETED

Phillips

KANSAS

Map No. 133 Sec. 2 Twp. 3 R. 19WWell No. 1 Grote

Carter Company

COMPLETED Contractor

C NE NE


660 Ft. from N. Line

Ft. from S. Line

660 Ft. from E. Line

Ft. from W. Line

SECTION PLAT

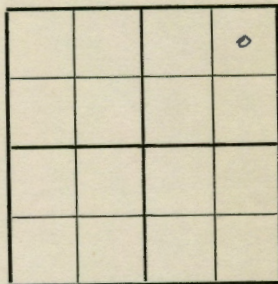

DAYTON POOL

Location _____

Rig up _____

Drilling and Remarks:

*Lane 3114**5" @ 3300**Per Lane.**10250 acil**Pump 66 Pst**35544*

RECORD

Cased _____ in., _____ ft.

Sand _____

Gas _____

Oil _____

Total Depth 3304

PRODUCTION

1st 24 hrs. Nat. _____

1st 24 hrs. after shot _____

Gas _____ Cu. Ft.

Dry Hole _____

Abandoned _____

Date

AUG 27 1942

19

S. J. LEWIS Scout

Phillips

KANSAS

Map No. 133 Sec. 2 Twp. 3 R. 19WWell No. 1 Grote

Carter Company

FIRST REPORT Contractor

C NE NE


660 Ft. from N. Line

Ft. from S. Line

660 Ft. from E. Line

Ft. from W. Line

SECTION PLAT

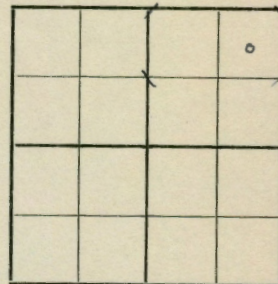

DAYTON POOL

Location XXX

Rig up _____

Drilling and Remarks:

RECORD

Cased _____ in., _____ ft.

Sand _____

Gas _____

Oil _____

Total Depth _____

PRODUCTION

1st 24 hrs. Nat. _____

1st 24 hrs. after shot _____

Gas _____ Cu. Ft.

Dry Hole _____

Abandoned _____

Date

JUN 17 1942

19

S. J. LEWIS Scout