

KANSAS


Phillips

FORM 51 5M 4-41 PETROL

Section 2 Township 3 Range 19-W
 Well No. #1 Weinman
 Company Tom Allan & Cohen

NORTH

Wildcat

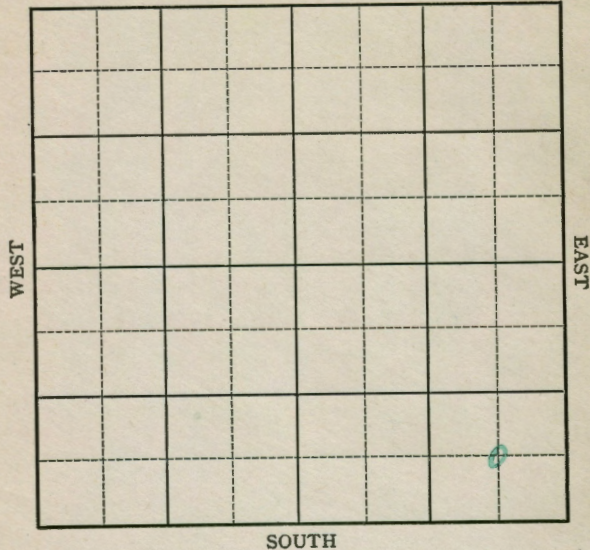

SOUTH

EAST

16

FORM 252-A 5M 6-41 PETROL


KANSAS

Phillips

Sec. 2 Twp. 3 R. 19-W
 Well No. #1 Weinman Farm
Tom Allan & Cohen Company
 (Wildcat)

Ft. from N. Line
660 Ft. from S. Line
660 Ft. from E. Line
 Ft. from W. Line

Elev. 2047

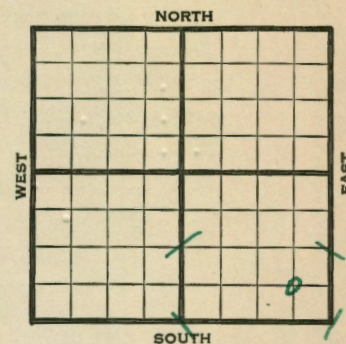

1942	REPORT
5/20	Surface hole.
5/27	8" - 61' Anhy. 1520'
	Drlg. 2646'
6/3	Topeka 2903' Lans. 3128'
	T.D. 3195' S.O. 5" - 3195' RUST.
6/10	T.D. 3248' 7000 acid.
	Swab 12 oil per hour.
6/17	" " "
6/24	TD 3248' SD.
7/1	" "
7/8	" "
7/15	Pump 400 oil in 24 hours.
7/22	" " " "
7/29	" " " "
8/5	" " " "
8/12	" " " "
8/19	" " " "
8/27	" " " "
9/2	" " " "
9/9	" " " "
9/16	" " " "
9/23	" " " "

OVER

1942

9/30 Pump 400 oil in 24 hrs.

10/7

Lans. 3128

5" - 3195

Perf. csg.

12000 acid

T.D. 3248

Pump 460 Pot.

Gravity 35.

COMPLETED

Map No. 133 Sec. 2 Twp. 3 R. 19WMap No. 133 Sec. 2 Twp. 3 R. 19WWell No. 1 WeinmanWell No. 1 Weinman

Tom Allan & Cohen Company


Tom Allan & Cohen Company

COMPLETED Contractor

FIRST REPORT Contractor

C SE SE

SECTION PLAT

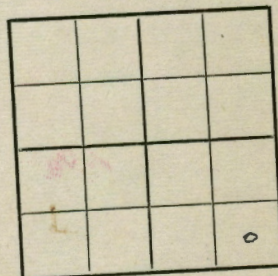

Ft. from N. Line

660 Ft. from S. Line

660 Ft. from E. Line

Ft. from W. Line

WILDCAT

Location

Rig up

Drilling and Remarks:

Loss 3/28.

5" C 3/95

Pex/csg.

12006 cu. ft.

Pump # 60 P.D.

350/4v

RECORD

Cased in, ft.

Sand

Gas

Oil

Total Depth 3248

PRODUCTION

1st 24 hrs. Nat.

1st 24 hrs. after shot

Gas Cu. Ft.

Dry Hole

Abandoned


Date

OCT 7 1942 19

S. J. LEWIS Scout

C SE SE

SECTION PLAT

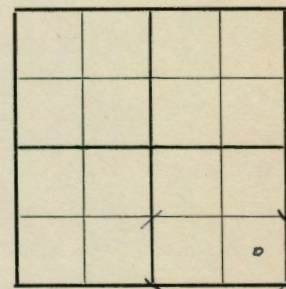

Ft. from N. Line

660 Ft. from S. Line

660 Ft. from E. Line

Ft. from W. Line

WILDCAT

Location

Rig up

Drilling and Remarks:

Surface Hole

RECORD

Cased in, ft.

Sand

Gas

Oil

Total Depth

PRODUCTION

1st 24 hrs. Nat.

1st 24 hrs. after shot

Gas Cu. Ft.

Dry Hole

Abandoned

Date

MAY 20 1942 19

S. J. LEWIS Scout