



Section 11 Township 3 Range 19-W
Well No. #1 August Eltiste
Company Carter

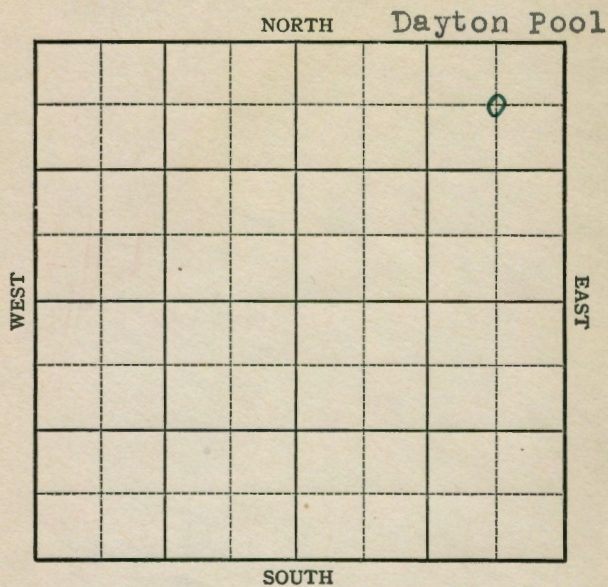

Sec. 11 Twp. 3 R. 19-W
Well No. #1 August Eltiste Farm
Carter Company
(Dayton)

660 Ft. from N. Line
 Ft. from S. Line
660 Ft. from E. Line
 Ft. from W. Line

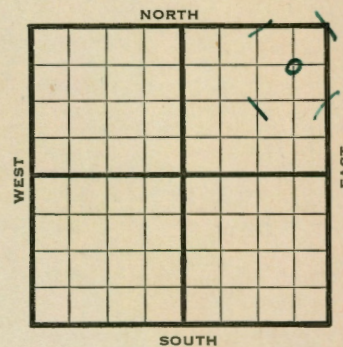

Ch. 2035

1942	REPORT
7/1	Drlg. 286'
7/8	8" - 287' Drlg. 2487'
7/15	Lans. 3118' S.O. 3118-20, 3185,-87, 3227-30' T.D. 3308' 5" - 3304' RUST.
7/22	"
7/29	Rip csg. 3118-3296' 4750 acid swb 5 oil P.H.
8/5	" " " "
8/12	" " " "
8/19	" " " "
8/27	Lans. 3118 5" - 3304 Perf. Lans. 4750 acid Pump 50 Pot. T.D. 3308 Gravity 35.8

COMPLETED

Phillips

KANSAS

Map No. 133 Sec. 11 Twp. 3 R. 19WWell No. 1 August Eltiste

Carter

Company

COMPLETED

Contractor

C NE NE

SECTION PLAT

660 Ft. from N. Line

Ft. from S. Line

660 Ft. from E. Line

Ft. from W. Line

				o

DAYTON POOL

Location _____

Rig up _____

Drilling and Remarks:

Laure 8118.
*5' 03304**Per Liane.*
*4700 acid**Pump 50 P.S.T.*
35 E/G

RECORD

Cased _____ in., _____ ft.

Sand _____

Gas _____

Oil _____

Total Depth 3308

PRODUCTION

1st 24 hrs. Nat. _____

1st 24 hrs. after shot _____

Gas _____ Cu. Ft.

Dry Hole _____

Abandoned _____

Date

AUG 27 1942 19 S. J. LEWIS Scout

Phillips KANSAS

Map No. 133 Sec. 11 Twp. 3 R. 19WWell No. 1 August Eltiste

Carter

Company

FIRST REPORT

Contractor

C NE NE

SECTION PLAT

660 Ft. from N. Line

Ft. from S. Line

660 Ft. from E. Line

Ft. from W. Line

				o

Dayton Pool

Location _____

Rig up _____

Drilling and Remarks:

Drlg. 286'

RECORD

Cased _____ in., _____ ft.

Sand _____

Gas _____

Oil _____

Total Depth _____

PRODUCTION

1st 24 hrs. Nat. _____

1st 24 hrs. after shot _____

Gas _____ Cu. Ft.

Dry Hole _____

Abandoned _____

Date

JUL 1 1942 19 S. J. LEWIS Scout