


Section 11 Township 3 Range 19-W

Well No. #1 Miller

Company Helmerich & Payne et al

Wildcat

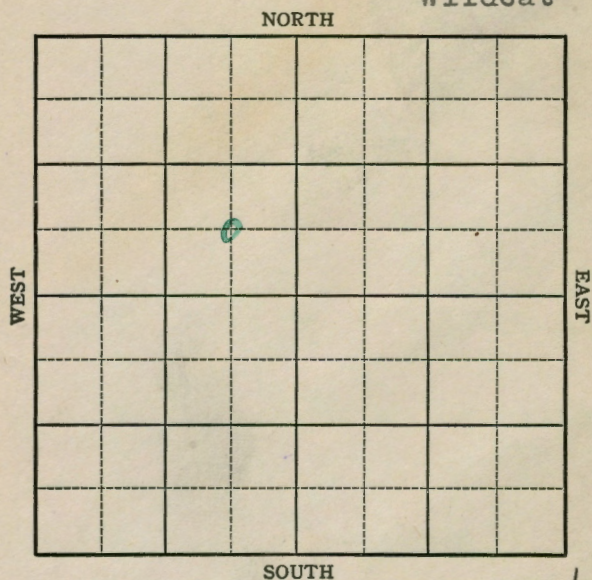

6

Sec. 11 Twp. 3 R. 19-W

Well No. #1 Miller Farm

Helmerich & Payne et al Company

(Wildcat)


Ft. from N. Line

660 Ft. from S. Line

660 Ft. from E. Line

_Ft. from W. Line

Elev. 2087

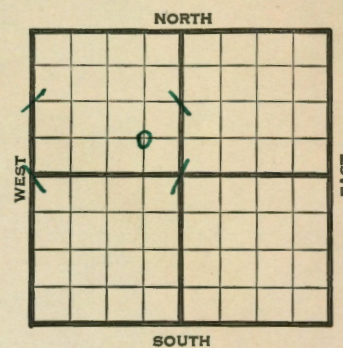[illegible]

Phillips


KANSAS

Map No. 133 Sec. 11 Twp. 3 R. 19WWell No. 1 MillerHelmerich & Payne et al. Company
ABANDONED

Contractor

C SE NW

SECTION PLAT

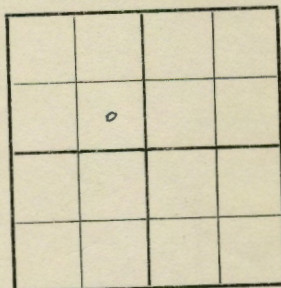

Ft. from N. Line

660 Ft. from S. Line

660 Ft. from E. Line

Ft. from W. Line

WILDCAT

Location

Rig up

Drilling and Remarks:

*Oil 3568**No. howe*

RECORD

Cased in, ft.

Sand

Gas

Oil

Total Depth *3680*

PRODUCTION

1st 24 hrs. Nat.

1st 24 hrs. after shot

Gas Cu. Ft.

Dry Hole

Abandoned

Date

MAY 27 1942 19

S. J. LEWIS

Scout

Phillips

KANSAS

Map No. 133 Sec. 11 Twp. 3 R. 19WWell No. 1 Miller


Helmerich & Payne et al. Company

FIRST REPORT

Contractor

C SE NW

SECTION PLAT

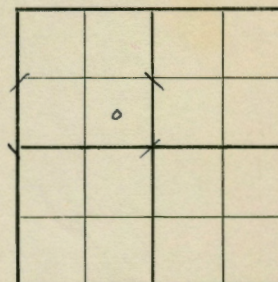

Ft. from N. Line

660 Ft. from S. Line

660 Ft. from E. Line

Ft. from W. Line

WILDCAT

Location

Rig up

Drilling and Remarks:

Drilling 2005'

10" - 270'

RECORD

Cased in, ft.

Sand

Gas

Oil

Total Depth

PRODUCTION

1st 24 hrs. Nat.

1st 24 hrs. after shot

Gas Cu. Ft.

Dry Hole

Abandoned

Date

MAY 13 1942 19

S. J. LEWIS

Scout