


Section 11 Township 3 Range 19Well No. #1 WeinmanCompany L. B. Stableford

NORTH

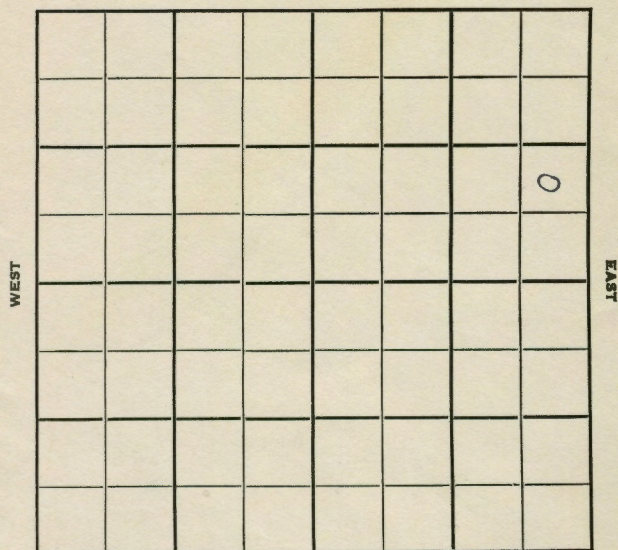

SOUTH

Sec. 11 Twp. 3 R. 19 WWell No. #1 Weinman FarmL. B. Stableford CompanyK & E Contractor


Ft. from N. Line

990 Ft. from S. Line330 Ft. from E. Line

Ft. from W. Line

NE SE NE

NORTH

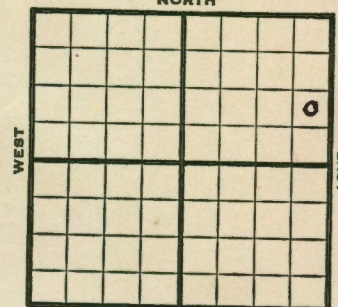

SOUTH

1952 Elev. 2020' REPORT

1/30 Spud 1-28-52
8" @ 200' WOC

2/5 Heeb. 3084 Tor. 3109 Lans. 3126
Drlg. 3195'

2/13 DST 3273-3302, 1 hr, 38' HOCM
10' free oil 400# HP
RTD 3350 5" @ 3349
12/3322-26, Test 1 gal wph
24/3298-3306 Testing

2/20 SSO 24/3282-88 2000 A
S/4 BOPH for 12 hrs. Decreased
to 2 BOPH Set plug 3242'
16/3222-26' SO 24/3222-30'
1000 A Testing

3/5 Testing

3/12 "

3/19 "

3/25 "

4/1 NR

4/9 "

4/23 NR

4/30 "

5/7 "

5/14 NR

5/21 "

OVER

1952
5/28

NR

6/4

Spud 1-28-52

Oil Well TD 3350

8" @ 200

Heeb. 3084 Tor. 3109

Lans. 3126

DST 3273-3302 opn 1 hr.

Rec. 38' hoem 10' free oil

TD 3350

5" @ 3349 12/3322-26 1 gwph

24/3298-3306 SSO 24/3282-88

2000 A S/4 boph dec. to 2 bopd

SP 3242 16/3222-26 SO 24/322-30

1000 A S P 3215 11/3206-10

39 goph 1000 A $1\frac{1}{2}$ boph SP 3190

12/3182-86 $1\frac{1}{2}$ goph 1000 A

S/2 boph SP 3174 12/3166-70

30 to 40 goph inc. to 2 boph


SP 3150 24/3132-38 $\frac{1}{2}$ goph 1000 A

S/7 boph dec. to 3 boph DP to bottom

S/10 bopd Comp. 54 bopd

COMPLETED

County Phillips State Kansas
 Sec. 11 (Blk. 3 (Sur. 19W Map No.
 Operator L. B. Stableford
 Well No. 1 Farm Weinman
 Elev. 2020 Location NE SE NE

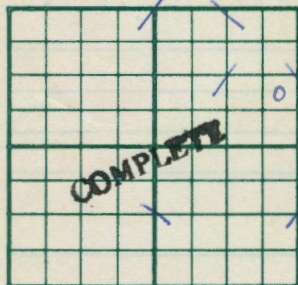


990 Ft. From S Line NE
330 Ft. From E Line Quarter
 Ist. Report
 Completion JUN 4 1952
 Remarks
K & E Drlg. - Contr.
 Spudding Date 1-28-52

Drlg. Data Oil well TD 3350
8" @ 200 Heeb. 3084 Tor. 3109
Lans. 3126 DST 3273-3302 open 1 hr.
Rec. 38' hocom 10' free oil TD 3350
5" @ 3349 12/ 3322-26 1 gwph
24/ 3298-3306 SSo 24/ 3282-88 2000 A
S/ 4 boph dec. to 2 bopd SP 3242
16/ 3222-26 SO 24/ 3222-30 1000 A
SP 3215 11/ 3206-10 39 goph 1000 A
1 1/2 boph SP 3190 12/ 3182-86 1 1/2 goph
1000 A S/ 2 boph SP 3174 12/ 3166-70
30 to 40 goph inc. to 2 boph SP 3150
24/ 3132-38 1/2 goph 1000 A S/ 7 boph
dec. to 3 boph DP to bottom S/ 10 bopd
Comp. 54 bopd

J. G. McGEHEE

County Phillips State Kansas
 Sec. 11 (Blk. 3 (Sur. 19 Map No.
 Operator L. B. Stableford
 Well No. 1 Farm Weinman
 Elev. Location NE SE NE

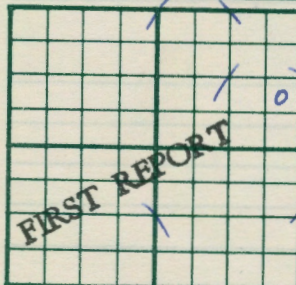

990 Ft. From S Line NE
330 Ft. From E Line Quarter
 Ist. Report JAN 30 1952
 Completion
 Remarks
K & E - Contr.
 Spudding Date 1-28-52

Drlg. Data
8" @ 200 WOC

J. G. McGEHEE