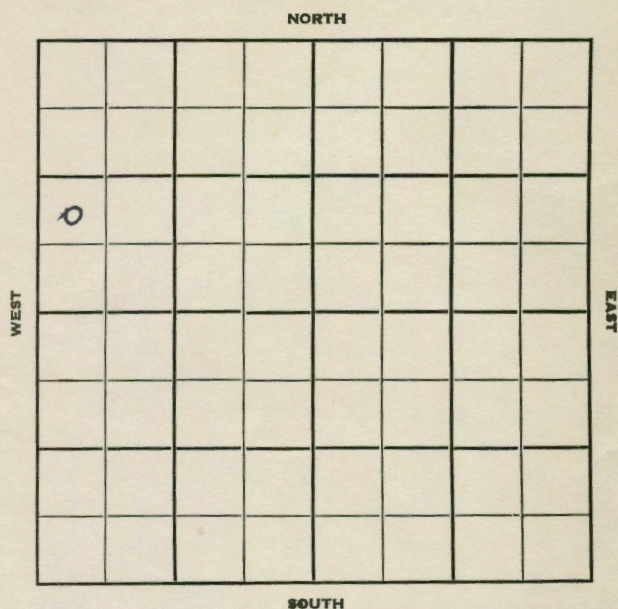


Phillips **KANSAS**Section 12 Township 3 Range 19WWell No. #1 KaiserCompany Lewis Drlg.


5

Phillips **KANSAS**Sec. 12 Twp. 3 R. 19 WWell No. #1 Kaiser FarmLewid Drilling CompanyLewis Drilling ContractorDayton
Ft. from N. Line990
Ft. from S. Line

Ft. from E. Line

330
Ft. from W. Line

NW SW NW

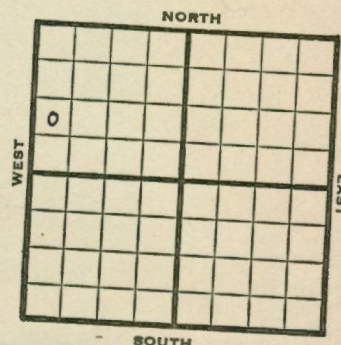1951 **Elev. 2023'** REPORT11/14
Spud 11-10-51
8" @ 145
Drlg. 1490'

1952
1/23

Spud 11-10-51
Oil well TD 3360' 8" @ 145
Heeb 3105' **Tor 3130'** **Lans. 3148'**
DST 3135-65 open 1 hr. rec 10' mud
& SSO
DST 3169-94' open 1-3/4 hr. rec 75'
MCO
DST 3206-34 open 1 hr. rec 10' OCM,
10' free oil
DST 3232-52 open 2 hr. rec 15' free oil
55' OCM
DST 3350-60 open 45 min, rec 720' OCM
5 1/2" @ 3360 CO to 3350
172/3293-3456 S/3 BWPB 15 GOPH
28/3334-44 28/3310-19 22/3293-
3300 S/10 BOPB
Comp. 65 BOPD

COMPLETED

County Phillips State Kansas
 Sec. 12 (Blk. 3 (Sur. 19W Map No.
 Operator Lewis Drlg.
 Well No. 1 Farm Kaiser
 Elev. 2023 Location NW SW NW

990 Ft. From S Line NW
 330 Ft. From W Line Quarter

1st. Report

Completion JAN 23 1952

Remarks Dayton Pool

Lewis Drlg. - Contr.

Spudding Date 11-10-51

Drlg. Data Oil well TD 3360

8" @ 145 Heeb. 3105 Tor. 3130

Lans. 3148 DST 3135-65 open 1 hr.

Rec. 10' mud & SSO DST 3169-94

open 1 3/4 hr. Rec. 75' mco DST 3206-34

open 1 hr. Rec. 10' ocm 10' free oil

DST 3232-52 open 2 hr. Rec. 15' free

oil 55' ocm DST 3350-60 open 45 min.

Rec. 720' ocm 5 1/2" @ 3360 CO to 3350

172/ 3293-3456 3/ 3 bwph 15 goph

28/ 3334-44 28/ 3310-19 22/ 3293-3300

S/ 10 boph Comp. 65 bopd

J. G. McGEHEE

County Phillips State Kansas
 Sec. 12 (Blk. 3 (Sur. 19W Map No.
 Operator Lewis Drilling
 Well No. 1 Farm Kaiser
 Elev. Location NW SW NW

990 Ft. From S Line NW

330 Ft. From W Line Quarter

1st. Report NOV 14 1951

Completion

Remarks

Lewis Drlg. - Contr.

Spudding Date 11-10-51

Drlg. Data

Dayton

8" @ 145 Drlg. 1490

J. E. TYRA