


Section 13 Township 3 Range 19W

Well No. #1 Chem - Bohl

Company Phillips Pet.

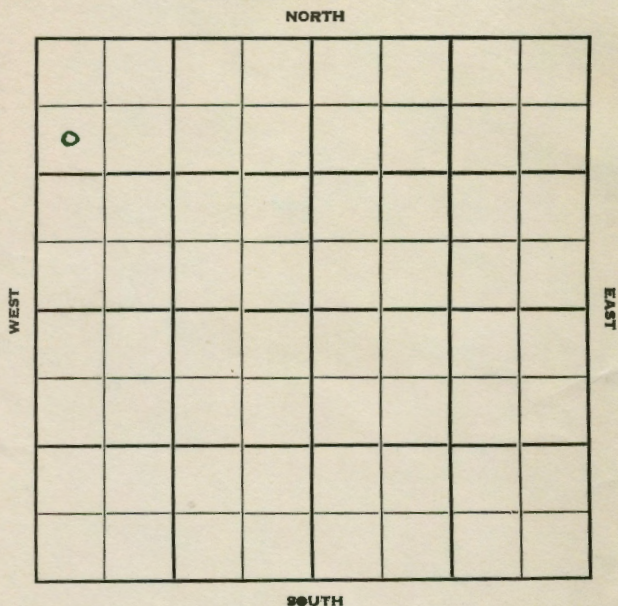

4

Sec. 13 Twp. 3 R. 19W

Well No. #1 Chem-Bohl

Phillips Pet.

Brack Oil

Stuttgart Pool


990 Ft. from N. Line

Ft. from S. Line

Ft. from E. Line

990 Ft. from W. Line

SW NW NW

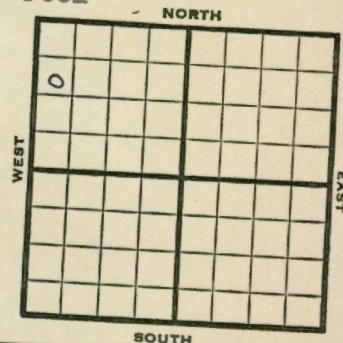

1951

Elev. 2018' REPORT

11/21

Spud 11-18-51  
8" @ 290' WOC

1952

1/23

Spud 11-18-51  
 Oil well TD 3390' 8" @ 290  
 Howard 2917' Top. 2944' Heeb 3105'  
 Tor. 3128' Lans. 3148' B KC 3376'  
 TD 3390' 5" @ 3390 CO to 3365  
 32/3320-38 32/3346-54 500 A  
 S/2 BW tr. oil 5 hr. 2000 A  
 S/1 1/2 BW tr. oil 3 hr. PB 3322  
 16/3246-50 500 A S/1 1/2 BO  
 1 1/4 BW 2 hr. 24/3302-08 no inc.  
 1000 A S/14 BO 5 BW 9 hr.  
 28/3183-90 3000 A S/45 BO 10 BW  
 12 hr. SP 3170 4/3154-64  
 24/3135-41 1000 A S/45 BO 7 BW  
 12 hr. 3000 A S/24 BO 3/4 BW  
 6 hr.  
 Comp. 90 BOPD 22 1/2 BW

COMPLETED

