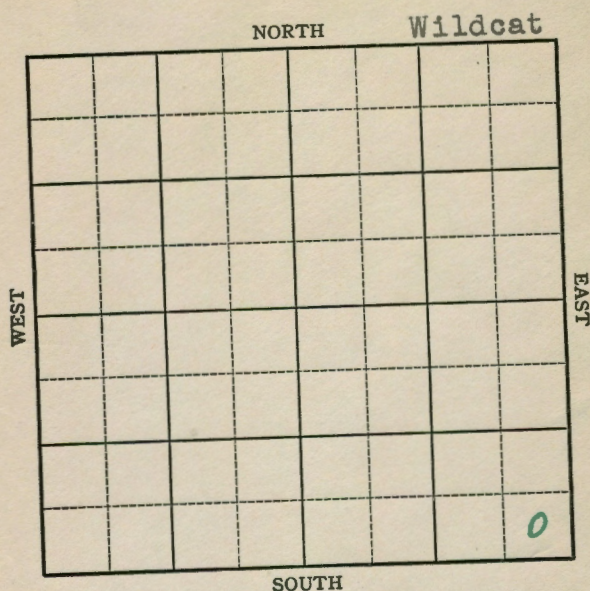


KANSAS

FORM 51 5M 10-41 PETROL

Phillips

Section 13 Township 3 Range 19-WWell No. #1 DillCompany Sinclair Prairie

FORM 252-A 5M 6-41 PETROL

KANSAS

Phillips

Sec. 13 Twp. 3 R. 19-WWell No. #1 Dill FarmSinclair-Prairie Company


(Wildcat)

Ft. from N. Line

330 Ft. from S. Line330 Ft. from E. Line

Ft. from W. Line

Elev. 1993

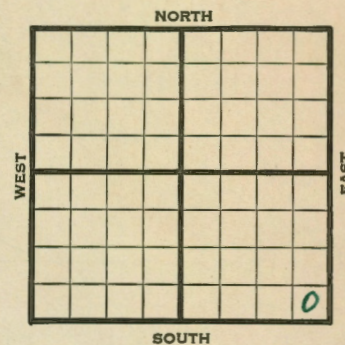

1942

REPORT

5/13

Location

5/20

8" - 136' Drlg. 2350'

5/27

Anhy. 1590' Topeka 3015'

Lans. 3240' Drlg. 3520'

6/3

Arb. 3640'

Granite 3888'

T.D. 3889'

No shows.

ABANDONED

Phillips

KANSAS

Map No. 133 Sec. 13 Twp. 3 R. 19WWell No. 1 Dill

Sinclair Prairie


Company

FIRST REPORT

Contractor

SE/C

SECTION PLAT

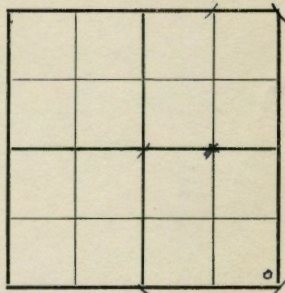

Ft. from N. Line

330 Ft. from S. Line330 Ft. from E. Line

Ft. from W. Line

WILDCAT

Location XXX

Rig up

Drilling and Remarks:

RECORD

Cased in, ft.

Sand

Gas

Oil

Total Depth

PRODUCTION

1st 24 hrs. Nat.

1st 24 hrs. after shot

Gas Cu. Ft.

Dry Hole

Abandoned

Date

MAY 13 1942 19

S. J. LEWIS

Scout

Phillips

KANSAS

Map No. 133 Sec. 13 Twp. 3 R. 19WWell No. 1 Dill

Sinclair-Prairie


Company

ABANDONED

Contractor

SE/C

SECTION PLAT

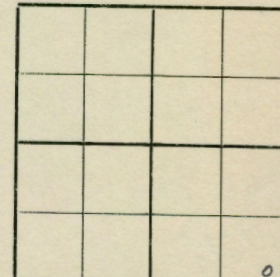

Ft. from N. Line

330 Ft. from S. Line330 Ft. from E. Line

Ft. from W. Line

WILDCAT

Location

Rig up

Drilling and Remarks:

Cor 43640Gran to 3888Nochowe

RECORD

Cased in, ft.

Sand

Gas

Oil

Total Depth 3888

PRODUCTION

1st 24 hrs. Nat.

1st 24 hrs. after shot

Gas Cu. Ft.

Dry Hole

Abandoned

Date

JUN 3 1942

19

S. J. LEWIS

Scout