


Section 13 Township 3 Range 19W

Well No. #1 Miller "A"

Company Phillips Petr.

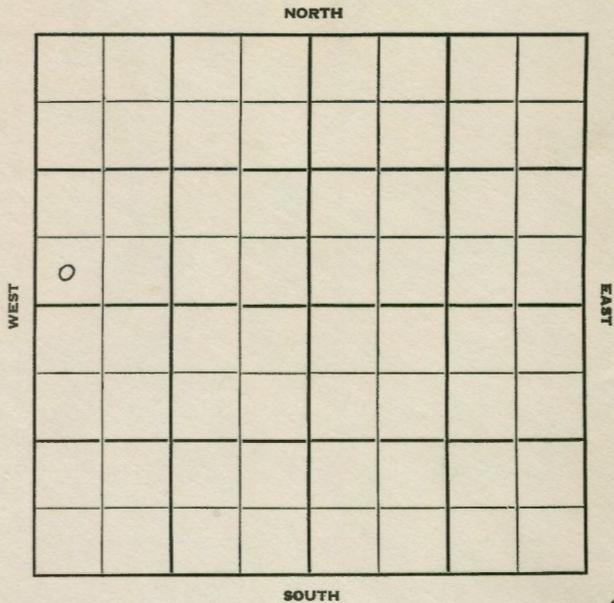

5

Sec. 13 Twp. 3 R. 19 W

Well No. #1 Miller "A" Farm

Phillips Pet. Company

B & R Drlg. Contractor


Stuttgart Pool
Ft. from N. Line

330 Ft. from S. Line

Ft. from E. Line

330 Ft. from W. Line

SW SW NW

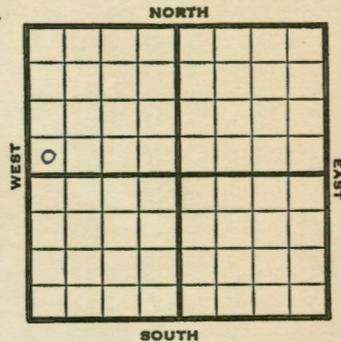

1951	Elev. 2002'	REPORT
4/18	Spud 4-15-51	
	Drlg. 1090'	
7/18	Spud 4-15-51	
	Oil well TD 3543'	
	8" @ 1213'	Anhy 1495' Heeb 3087'
	1 st or. 3114'	Lans. 3129' B K C 3356
	Cong. 3500'	Arb. 3538' TD 3543'
	5" @ 3394'	CO to 3360' 28/3328-35
	B/2 GO 61 GW 8 hr.	SP 3323'
	36/3300-09 500 A	14 GW 6 GO
	1 1/2 hr.	44/3283-94 B/2 GO
	8 GWPH PB 3295'	2000 A
	B/2 1/2 BW 1/2 BO 4 1/2 hr.	SP 3271'
	24/ 3260-66 500 A	B/4 GO
	26 GW 2 hr.	CO to 3323'
	SP 3250'	28/3211-18 500 A
	6 BOPH 2000 A	S/1 BO
	5 GWPH CO to 3319'	SP 3195'
	36/3162-71 S/45 BO	3 BW 9 hr.
	SP 3150'	32/3130-38 S/3 BOPH
	3000 A S/69 BO	13 hr.
	Drove plug 3342'	S/23 BO 3 hr.
	SP 3250'	
	Comp. 134 BOPH	4% water.

COMPLETED

