



FORM 51 25M 8-50 WESTERN **Phillips KANSAS**
 Section 23 Township 3 Range 19 W
 Well No. # 1 Elm
 Company Westgate-Greenwood

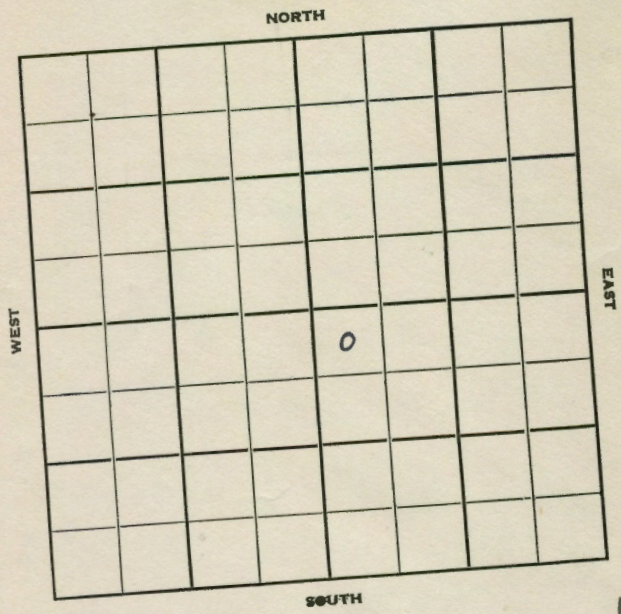

10

Phillips KANSAS
 Sec. 23 Twp. 3 R. 19W
 Well No. #1 Elm Farr
Westgate-Greenland Company
Jackson Drlg. -Contr. Contractor
Wildcat

330' Ft. from N. Line
 _____ Ft. from S. Line
 _____ Ft. from E. Line
330' Ft. from W. Line
 NW NW SE

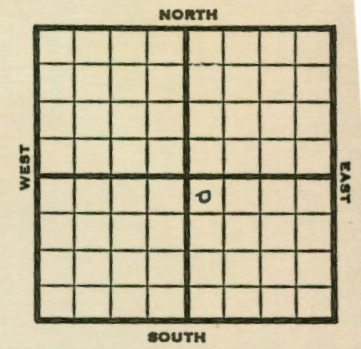

1951	Elev. 1990'	REPORT
2/21	Spud 2-18-51 8" @ 215' Drlg. 1462'	
4/25	Spud 2-18-51 Oil well TD 3488' 8" @ 215 Heeb 3084' Toronto 3110 Lans 3127 DST 3168-3212 open 1 hr. rec 20' OCM DST 3222-65 open 1 hr. rec 12' mud DST 3267-97 open 45 min. rec 30' HOOM, 3' oil, TD 3488' 5" @ 3363 12/3324-28 12/3307-11 24/3300-04 6/3291-93 18/3282-88 SO 6/3272-74 18/3260-68 SSO Arb. 3476' SP 3293 500 A S/1 1/2 BOPH 1000 A SP 3252 35/3228-42 12/3212-16 6/3196-98 16/3188-94 SSO 1000 A S/2 BOPH 1000 A S/2 1/2 BOPH SP 3154 93/3112-44 water 35/3130-39 B/1 GW SSO DP 3293 S/5 1/2 BO 1 hr 4 BO 2nd hr. Comp. 37 BOPD	
COMPLETED		

County	Phillips		State	Kansas	
Sec.	23	(Blk. Twp.)	3	(Sur. Rge.)	19W Map No.
Operator	Westgate-Greenland				
Well No.	1	Farm	Ehm		
Elev.	1990	Location	NW NW SE		

330 Ft. From	N	Line	SE
330 Ft. From	W	Line	Quarter
1st. Report			
Completion	APR 25 1951		
Remarks	Wildcat		
Jackson Drlg. - Contr.			
Spudding Date	2-18-51		

Drig. Data	Oil well	TD 3488
8" @ 215	Heeb. 3084	Toronto 3110
Lans. 3127	DST 3168-3212	open 1 hr.
Rec. 20' ocm	DST 3222-65	open 1 hr.
Rec. 12' mud	DST 3267-97	open 45 min.
Rec. 30' hocm	3' oil	TD 3488 5" @ 3363
12/ 3324-28	12/ 3307-11	24/ 3300-04
6/ 3291-93	18/ 3282-88	SO 6/ 3272-74
18/ 3260-68	SSO Arb. 3476	SP 3293
500 A S/ 1½ boph	1000 A	SP 3252
35/ 3228-42	12/ 3212-16	6/ 3196-98
16/ 3188-94	SSO 1000 A	S/ 2 boph
1000 A S/ 2½ boph	SP 3154	93/ 3112-44
water 35/ 3130-39	B/ 1 gw	SSO DP 3293
S/ 5½ bo 1 hr.	4 bo	2nd hr Comp. 37 bopd

J. E. TYRA

County	Phillips			State	Kansas
Sec.	23	(Blk. Twp.)	3	(Sur. Rge.)	19W Map No.
Operator	Westgate-Greenland				
Well No.	1	Farm	Ehm		
Elev.	NW NW S2				

FIRST REPORT

330	Ft. From	N	Line	SE
330	Ft. From	W	Line	Quarter
1st. Report FEB 21 1951				
Completion				
Remarks				
Jackson Drlg. - Contr.				
Spudding Date		2-18-51		

Drlg. Data	Wildcat
8* @ 215	drlg. 1462

J. E. TYRA