


Phillips **KANSAS**

Section 31 Township 3 Range 19W

Well No. #1 Merkelein

Company Nadel & Gussman

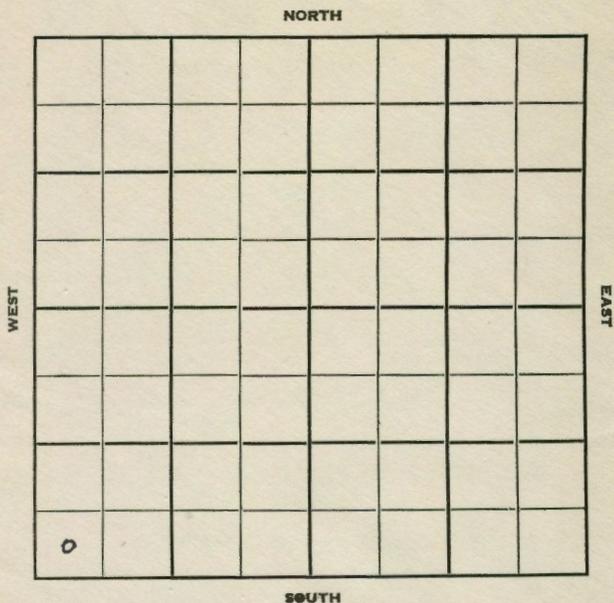

13

Phillips **KANSAS**

Sec. 31 Twp. 3 R. 19W

Well No. #1 Merkelein

Nadel & Gussman Company

K & E Drlg. - Contr. Contract

Wildcat

Ft. from N. Line

330'


Ft. from S. Line

Ft. from E. Line

330'

Ft. from W. Line

SW SW SW

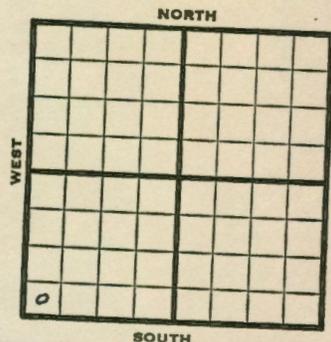

1950 **Elev 2082'** REPORT

12/6 Spud 12-1-50
8-5/8" @ 169'

Anhy 1670'

Drlg. 2530'

12/20 8 5/8" @ 169

Anhy 1670

Heeb 3263

Lans 3302

DST 3373-3409 opn 1/2 hr rec 45' mud & SSO

Arb 3605

TD 3646

D&A

ABANDONED

County Phillips State Kansas

Sec. 31 (Blk. 3) (Sur. 19W) Map No.

Operator Nadel & Gussman

Well No. 1 Farm Merklein

Elev. 2082 Location SW SW SW

330 Ft. From S Line SW

330 Ft. From W Line Quarter

1st. Report

Completion DEC 20 1950

Remarks Wildcat

K & E Drlg. - Contr.

Spudding Date 12-1-50

Drlg. Data D & A TD 3646

8 5/8" @ 169 Anhy 1670 Heeb. 3263

Lens. 3302 DST 3373-3409 open 1/2 hr.

Rec. 45' mud & SSO Arb. 3605 TD 3646

D & A

J. E. TYRA

County Phillips State Kansas

Sec. 31 (Blk. 3) (Sur. 19W) Map No.

Operator Nadel & Gussman

Well No. 1 Farm Merklein

Elev. Location SW SW SW

330 Ft. From S Line SW

330 Ft. From W Line Quarter

1st. Report DEC 6 1950

Completion

Remarks

K & E Drlg. - Contr.

Spudding Date 12-1-50

Drlg. Data Wildcat

8 5/8" @ 169 Anhy 1670 drlg. 2530

J. E. TYRA