


KANSAS

Section 35 Township 3 Range 19W
 Well No. #1 Graw
 Company Phillips

NORTH

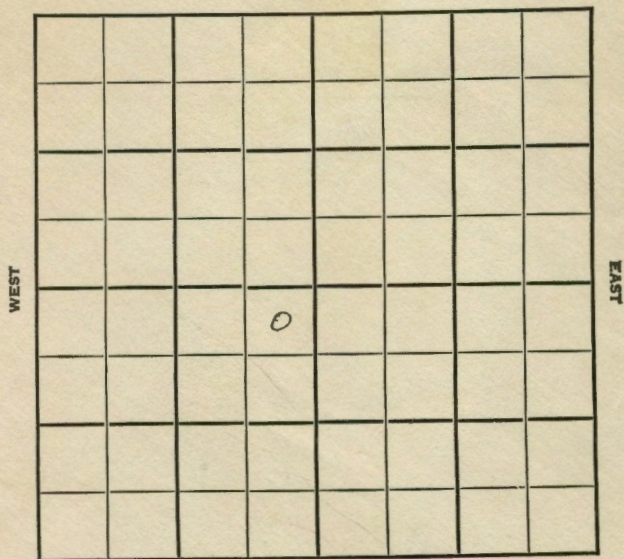

SOUTH

EAST

5M 9-47 PETROL

KANSAS

Phillips V

Sec. 35 Twp. 3 R. 19W

Well No. #1 Graw Farm
Phillips Company
Wildcat

330 Ft. from N. Line


Ft. from S. Line

330 Ft. from E. Line

Ft. from W. Line

NE SW

NORTH

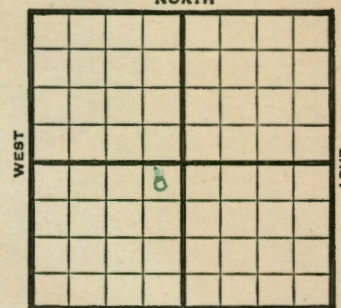

SOUTH

1947 Elev. 2071' REPORT

11/19 Location
 11/25 RUR
 12/3 8" @ 1597'
 Drlg. 2120'
 12/10 Lansing 3219'
 BKC 3444'
 Arbuckle 3562'
 TD 3600'
 12/17 Arbuckle 3562'
 TD 3615'
ABANDONED

Map No. 133 Sec. 35 Twp. 3 R. 19WWell No. 1 Grau

Phillips

Company

ABANDONED

Contractor

NE SW

SECTION PLAT

330 Ft. from N. Line

Ft. from S. Line

330 Ft. from E. Line

Ft. from W. Line

Phillips County

Location

RECORD

Cased _____ in., _____ ft.

Sand _____

Gas _____

Oil _____

Total Depth 8645

PRODUCTION

1st 24 hrs. Nat. _____

1st 24 hrs. after shot _____

Gas _____ Cu. Ft.

Dry Hole _____

Abandoned _____

Date

DEC 17 1947

19

S. J. LEWIS

Scout

Map No. _____ Sec. 35 Twp. 3 R. 19WWell No. 1 Graw

Phillips

Company

FIRST REPORT

Contractor

NE SW

SECTION PLAT

330 Ft. from N. Line

Ft. from S. Line

330 Ft. from E. Line

Ft. from W. Line

Phillips County

Location X

RECORD

Cased _____ in., _____ ft.

Sand _____

Gas _____

Oil _____

Total Depth _____

PRODUCTION

1st 24 hrs. Nat. _____

1st 24 hrs. after shot _____

Gas _____ Cu. Ft.

Dry Hole _____

Abandoned _____

Date

NOV 19 1947

19

S. J. LEWIS

Scout