



Section 36 Township 19W Range 19W
 Well No. 1 H. F. Beckman
 Company Sohio Pet

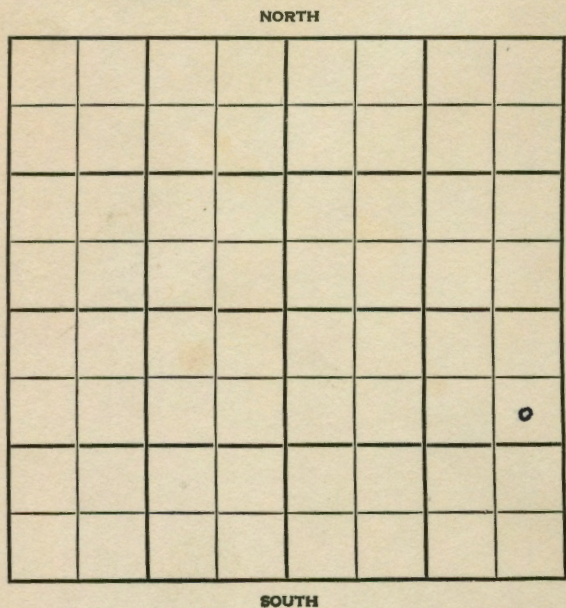

9

Phillips KANSAS
 SEC. 36 TWP. 3 R. 19W
 WELL NO. 1 H. F. Beckman
 COMPANY Sohio Pet FARM

CONTRACTOR Bill Hay
Wildcat
990 Ft. from N. Line
 _____ Ft. from S. Line
330 Ft. from E. Line
 _____ Ft. from W. Line

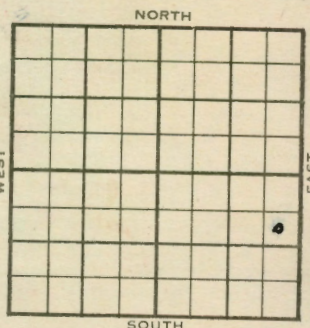

SE NE SE

| 1954 | ELEVATION | REPORT |
|------|-----------|---|
| | 1995' | |
| 6/8 | | Spudding 6-6-54 8" @ 308 Drlg. 400 |
| 6/23 | | Spud 6-6-54 D&A TD 3633' 8" @ 308' Anhy 1555', Heeb 3187', Tor 3212', Lans 3225' DST 3262-74', opn 1 hr., rec. 8' mud, 1080# DST 3277-3305', opn 1 hr., rec. 10' mud, 30# DST 3374-92', opn 1 hr., rec. 15' mud DST 3392-3414', opn 1 hr., rec. 27' mud, 210# B KC 3449', Marm. 3480', Arb. 3570' TD 3633' D&A |
| | | ABANDONED |

